

NEWTON

K

2011

MISSISSIPPI BOARD OF WATER COMMISSIONERS 416 North State Street Jackson, Mississippi 39201

WATER WELL DRILLERS LOG

3-16-78 date well completed 1978 Williamson Drilling Co. firm name Newton county well located

LANDOWNER: Sadie Hale

description of formations encountered

from

to

Chunky Mrs. (mailing address)

top soil 0 31
red clay 31 48
red sand 48 70
white sand 70 65
rock & clay 65 178
sand 178 242

WELL LOCATION:

sec 22 T 6 N 2 miles N.W. of Newton

WELL PURPOSE: Home (home, irrigation/municipal, industrial)

WELL COMPLETION DATA:

- (1) diameter (inches) 4
(2) total depth (feet) 242
(3) static water level (feet) 110 below top of ground
(4) casing (material) PVC (depth) 152
(5) screen (size) 4 (length) no (depth to top) no
(6) pump (HP) 1/2 (material) 6 (yield gpm) Electric (type power)
(7) electric log no (yes or no) no (organization running log)
(8) how well bottom plugged open


RECEIVED MAY 24 1978

DRILLERS REMARKS:

MISS. BD. OF WATER COMMISSIONERS

If well telescopes please sketch and show depths.

GROUND LEVEL

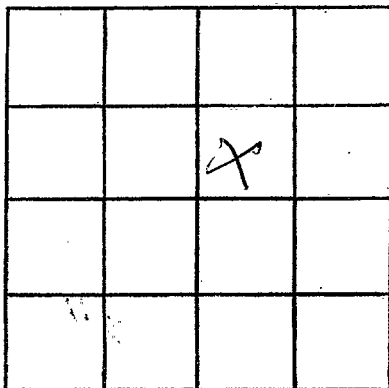

SECTION 22

Please indicate well location X.

ADDITIONAL INFORMATION

If more than one screen, show locations of each on sketch.