

NEWTON
K 2012
8-24-78

MISSISSIPPI
BOARD OF WATER COMMISSIONERS
416 North State Street
Jackson, Mississippi 39201

WATER WELL DRILLERS LOG


8-24-78 date well completed McDonald & Hill firm name Newton county well located

LANDOWNER:	description of formations encountered	from	to
Don Baker	clay & sand	0	20
RT# 1 Newton (mailing address)	sand & clay	20	130
WELL LOCATION: sec. 14 T. 6 N R. 11 E 1 1/2 miles N of Newton (distance) (direction) (nearest town)	sand & shale & lignite	130	210
WELL PURPOSE: <u>home</u> (home, irrigation, municipal, industrial)	sandy shale	210	245
WELL COMPLETION DATA:	shale	245	275
(1) diameter (inches) 2 1/2"	Rock + shells	275	305
(2) total depth (feet) 320'	green sand	305	320
(3) static water level (feet) 80' below top of ground.			
(4) casing PVC 260' (material) (depth) 4" (size) if telescope see back.			
(5) screen (length) (depth to top) (size) (material)			
(6) pump 3/4 HP 175 GPM (material) (HP) (yield gpm)			
(7) electric log (yes or no)			
(8) how well bottom plugged Open (organization running log)			
DRILLERS REMARKS:			

RECEIVED
AUG 23 1978
MISS. BD. OF WATER COM.

If well telescopes please sketch and show depths.

GROUND LEVEL

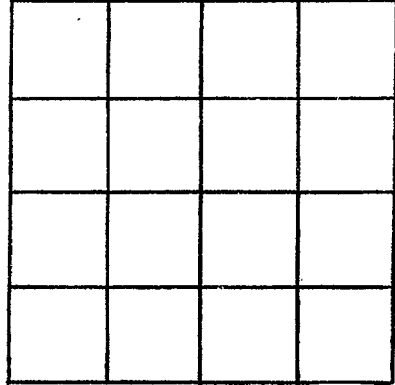

SECTION _____

Please indicate well location X.

ADDITIONAL INFORMATION

Lined area for additional information.

If more than one screen, show locations of each on sketch.