

NEWTON

K 2013

8-22-78

MISSISSIPPI BOARD OF WATER COMMISSIONERS 416 North State Street Jackson, Mississippi 39201

WATER WELL DRILLERS LOG

8-22-78

McDonald & Hill

Newton

date well completed

firm name

county well located

LANDOWNER:

Bernard Yeldman

description of formations encountered

clay + sand

from

to

0

20

Rt # 1 Newton

(mailing address)

sandy shale + shell

20

40

WELL LOCATION:

sec. 14 T 6 N R 11 E

1 1/2 miles NW of Newton

(distance) (direction) (nearest town)

sandy shale

40

50

sand

50

90

sand + st shale

90

210

WELL PURPOSE: home (home, irrigation, municipal, industrial)

sandy shale

210

250

WELL COMPLETION DATA:

shale

250

280

(1) diameter (inches) 4"

Rock + shells

280

307

(2) total depth (feet) 320'

(3) static water level (feet) 85' below top of ground

green sand

307

320

(4) casing PVC 305' (material) (depth)

4" (size) if telescope see back.

(5) screen 15' 305' to 320' (length) (depth to top)

4" PVC (size) (material)

(6) pump 3 25 gpm (HP) (yield gpm)

2 (type power)

(7) electric log (yes or no)

(organization running log)

(8) how well bottom plugged 1 valve


DRILLERS REMARKS:

RECEIVED AUG 29 1978

MISS. BD. OF WATER COMMISSIONERS

If well telescopes please sketch and show depths.

GROUND LEVEL

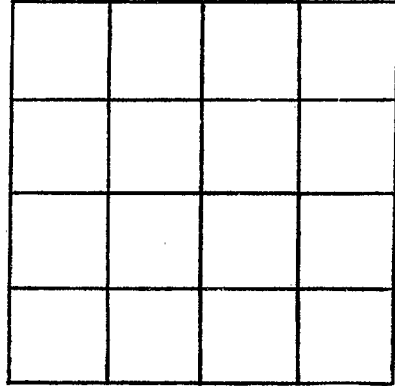

SECTION _____

Please indicate well location X.

ADDITIONAL INFORMATION

A series of horizontal lines for recording additional information, starting below the 'ADDITIONAL INFORMATION' header and extending to the bottom of the page.

If more than one screen, show locations of each on sketch.