

NEWTON

K 2015

6/26/79

MISSISSIPPI BOARD OF WATER COMMISSIONERS 416 North State Street Jackson, Mississippi 39201

WATER WELL DRILLERS LOG

6/26/1979 date well completed

Jerry D firm name

Newton county well located

LANDOWNER: George Bishop

description of formations encountered

from to

RT 1 Box 71

yellow clay

0 25'

Newton Miss (mailing address)

sandy

25 120

clay

120 180

clay

180 280

sandy

280 325

WELL LOCATION:

sec 14 T 6N R 4 E

7 miles N of Newton (distance) (direction) (nearest town)

WELL PURPOSE:

(home, irrigation, municipal, industrial)

WELL COMPLETION DATA:

- (1) diameter (inches) 4"
(2) total depth (feet) 325
(3) static water level (feet) 100 below top of ground
(4) casing PVC 240 (material) (depth)

(size) if telescope see back.

- (5) screen No (length) (depth to top)

(size) (material)

- (6) pump 1/2 (HP) 6 (yield gpm)

Sub (type power)

- (7) electric log (yes or no)

(organization running log)

- (8) how well bottom plugged Open

DRILLERS REMARKS:


DEPT. OF NATURAL RESOURCES BUREAU OF LAND & WATER

MAR 31 1981

RECEIVED

If well telescopes please sketch and show depths.

GROUND LEVEL

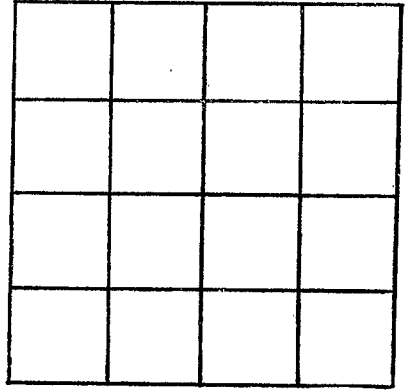

SECTION \_\_\_\_\_

Please indicate well location X.

ADDITIONAL INFORMATION

If more than one screen,  
show locations of each on sketch.