

NEWTON
K 2017
04-19-79

MISSISSIPPI
BOARD OF WATER COMMISSIONERS
416 North State Street
Jackson, Mississippi 39201

WATER WELL DRILLERS LOG


4-19-79 19 McDonald & Hill Newton
date well completed firm name county well located

LANDOWNER:	description of formations encountered	from	to
<u>Wesley Mayes</u>	<u>clay + sand</u>	<u>0</u>	<u>15</u>
<u>Rt # 9 Decatur</u> (mailing address)	<u>shale of sand & clay</u>	<u>15</u>	<u>30</u>
WELL LOCATION: sec. <u>10</u> T <u>6</u> N R <u>11</u> E <u>5</u> miles <u>N</u> of <u>Newton</u> (distance) (direction) (nearest town)	<u>shale</u>	<u>30</u>	<u>50</u>
	<u>sandy shale</u>	<u>50</u>	<u>140</u>
	<u>shale & lignite</u>	<u>140</u>	<u>190</u>
WELL PURPOSE: <u>home</u> (home, irrigation, municipal, industrial)	<u>sand & shale</u>	<u>190</u>	<u>220</u>
WELL COMPLETION DATA:	<u>sand & st shale</u>	<u>220</u>	<u>280</u>
(1) diameter (inches) <u>4"</u>	<u>sandy</u>	<u>280</u>	<u>320</u>
(2) total depth (feet) <u>400'</u>	<u>shale</u>	<u>320</u>	<u>360</u>
(3) static water level (feet) <u>160'</u> below top of ground.	<u>Rock & shells</u>	<u>360</u>	<u>385</u>
(4) casing <u>PVC</u> , <u>300'</u> (material) (depth)	<u>green sand</u>	<u>385</u>	<u>400</u>
<u>4"</u> If telescope see back. (size)			
(5) screen _____ (length) (depth to top)			
_____ (size) _____ (material)			
(6) pump <u>30</u> <u>1000</u> (HP) (yld gpm)			
<u>E</u> (type power)			
(7) electric log _____ (yes or no)			
_____ (organization running log)			
(8) how well bottom plugged <u>Open!</u>			
DRILLERS REMARKS:			

Miss. Board of Water Comm.
APR 23 1979
RECEIVED

If well telescopes please sketch and show depths.

GROUND LEVEL

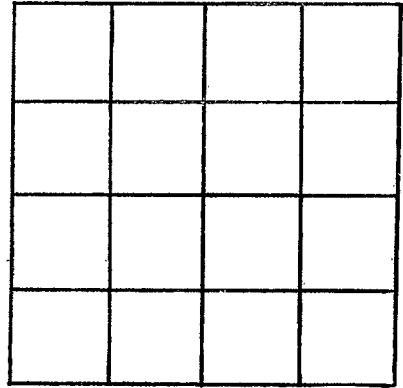

SECTION _____

Please indicate well location X.

ADDITIONAL INFORMATION

If more than one screen,
show locations of each on sketch.