

NEWTON
K 2018
11-14-80

MISSISSIPPI
 BOARD OF WATER COMMISSIONERS
 416 North State Street
 Jackson, Mississippi 39201

WATER WELL DRILLERS LOG

11-14-80 19 McDonald & Hill Newton
 date well completed firm name county well located


LANDOWNER:	description of formations encountered	from	to
<u>Leon Williams</u> <u>Rt #10 Lawrence</u> (mailing address)			
	<u>shale</u>	<u>42</u>	<u>70</u>
WELL LOCATION:	<u>sandy shale</u>	<u>70</u>	<u>140</u>
sec. <u>4</u> T. <u>6N</u> R. <u>11E</u> <u>5</u> miles <u>N</u> of <u>Newton</u> (distance) (direction) (nearest town)	<u>shale & sand</u>	<u>140</u>	<u>215</u>
WELL PURPOSE: (home, irrigation, municipal, industrial)	<u>sand & shale</u>	<u>215</u>	<u>290</u>
WELL COMPLETION DATA:	<u>sandy shale</u>	<u>290</u>	<u>330</u>
(1) diameter (inches) <u>4"</u>	<u>shale</u>	<u>330</u>	<u>365</u>
(2) total depth (feet) <u>400'</u>	<u>Rock & shells</u>	<u>365</u>	<u>393</u>
(3) static water level (feet) <u>160'</u> below above ground.	<u>greensand & sandy shale</u>	<u>393</u>	<u>420</u>
(4) casing <u>PVC</u> , <u>340'</u> , (material) (depth) <u>4"</u> if telescope see back. (size)			
(5) screen _____ (length) (depth to top) (size) (material)			
(6) pump <u>30</u> <u>80.0M</u> (HP) (yield gpm) <u>F</u> (type power)			
(7) electric log _____ (yes or no) (organization running log)			
(8) how well bottom plugged <u>DN</u>			
DRILLERS REMARKS:			

DEPT. OF NATURAL RESOURCES
 BUREAU OF LAND & WATER RESOURCES

NOV 25 1980
 RECEIVED

If well telescopes please sketch and show depths.

GROUND LEVEL

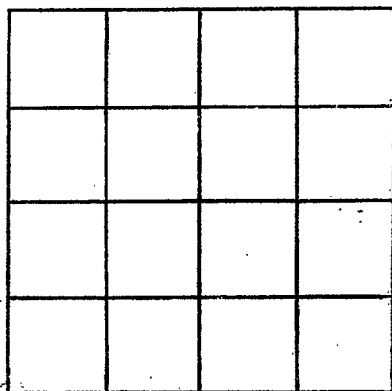

SECTION _____

Please indicate well location X.

ADDITIONAL INFORMATION

If more than one screen, show locations of each on sketch.