

Newton  
K 2019  
2-28-80

MISSISSIPPI  
BOARD OF WATER COMMISSIONERS  
416 North State Street  
Jackson, Mississippi 39201

2

WATER WELL DRILLERS LOG

2-22-80 19 McDonald + Hill Newton  
date well completed firm name county well located

LANDOWNER:	description of formations encountered	from	to
<u>H. M. Chamblee</u>	<u>sand at clay</u>	<u>0</u>	<u>20</u>
<u>RT # 1 Box 191A, Newton</u> (mailing address)	<u>sand</u>	<u>20</u>	<u>195</u>
WELL LOCATION: sec <u>23</u> T <u>6</u> N R <u>1</u> E <u>1</u> miles <u>N</u> of <u>Newton</u> (distance) (direction) (nearest town)	<u>sandy shale</u>	<u>195</u>	<u>230</u>
	<u>shale</u>	<u>230</u>	<u>268</u>
	<u>Rock &amp; shells</u>	<u>268</u>	<u>293</u>
WELL PURPOSE: <u>home</u> (home, irrigation, municipal, industrial)	<u>green sand &amp; shales</u>	<u>293</u>	<u>320</u>
	<u>shale</u>		
WELL COMPLETION DATA:			
(1) diameter (inches) <u>4"</u>			
(2) total depth (feet) <u>320</u>			
(3) static water level (feet) <u>60</u> below above top of ground.			
(4) casing <u>PUC</u> <u>250'</u> (material) (depth)			
<u>4"</u> If telescope see back. (size)			
(5) screen _____ (length) _____ (depth to top)			
(size) _____ (material)			
(6) pump <u>1/2</u> <u>10 gpm</u> (HP) (yield gpm)			
(type power)			
(7) electric log _____ (yes or no)			
(organization running log)			
(8) how well bottom plugged <u>open</u>			
DRILLERS REMARKS:			


DEPT. OF NATURAL RESOURCES  
BUREAU OF LAND & WATER RESOURCES

MAR 10 1980

RECEIVED

If well telescopes please sketch and show depths.

GROUND LEVEL

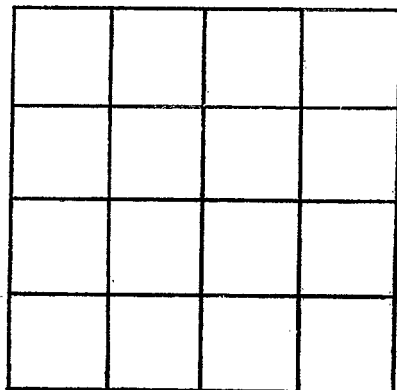

SECTION \_\_\_\_\_

Please indicate well location X.

ADDITIONAL INFORMATION

If more than one screen, show locations of each on sketch.