

Newton
K 2020
6-6-80

MISSISSIPPI
 BOARD OF WATER COMMISSIONERS
 416 North State Street
 Jackson, Mississippi 39201

WATER WELL DRILLERS LOG

6-6-80 19 McDonald's Well Newton
 date well completed firm name county well located

LANDOWNER:	description of formations encountered	from	to
<u>Bella Hrabree</u>	<u>Clay & sand</u>	<u>0</u>	<u>12</u>
<u>Box # 1 Newton</u> (mailing address)	<u>shale</u>	<u>12</u>	<u>50</u>
WELL LOCATION:	<u>sandy shale</u>	<u>50</u>	<u>90</u>
sec. <u>15</u> T. <u>6</u> N R. <u>11</u> E	<u>shale of sand</u>	<u>90</u>	<u>130</u>
<u>4</u> miles <u>N</u> of <u>Newton</u>	<u>sand</u>	<u>130</u>	<u>250</u>
(distance) (direction) (nearest town)	<u>sandy shale</u>	<u>250</u>	<u>285</u>
WELL PURPOSE: <u>home</u> (home, irrigation, municipal, industrial)	<u>shale</u>	<u>285</u>	<u>330</u>
WELL COMPLETION DATA:	<u>Rock & shells</u>	<u>330</u>	<u>360</u>
(1) diameter (inches) <u>4"</u>	<u>green sand & sandy shale</u>	<u>360</u>	<u>380</u>
(2) total depth (feet) <u>380'</u>			
(3) static water level (feet) <u>135'</u> below top of ground.			
(4) casing <u>PVC, 302'</u> (material) (depth)			
<u>4"</u> if telescope see back. (size)			
(5) screen _____ (length) (depth to top)			
(size) _____ (material)			
(6) pump <u>3/4</u> <u>100 gpm</u> (HP) (y/s/d/gpm)			
(type power) _____			
(7) electric log _____ (yes or no)			
(organization running log) _____			
(8) how well bottom plugged <u>open</u>			
DRILLERS REMARKS:			


DEPT. OF NATURAL RESOURCES
 BUREAU OF LAND & WATER RESOURCES

JUN 18 1980

RECEIVED

If well telescopes please sketch and show depths.

GROUND LEVEL

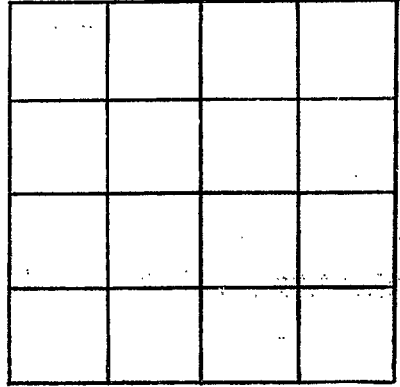

SECTION _____

Please indicate well location X.

ADDITIONAL INFORMATION

If more than one screen, show locations of each on sketch.