

Newton  
K 2001  
6-10-80

MISSISSIPPI  
BOARD OF WATER COMMISSIONERS  
416 North State Street  
Jackson, Mississippi 39201

WATER WELL DRILLERS LOG

6-10-80 19 McDonald's Hill Newton  
date well completed firm name county well located

LANDOWNER:	description of fomations encountered	from	to
Roach Jones	clay & sand	0	20
Box #1 Box 86, Newton (mailing address)	sand	20	45
WELL LOCATION:	shale	45	80
sec. 3 T. 6 N. R. 11 E	sandy shale	80	160
6 miles S of Newton (distance) (direction) (nearest town)	shale & st sand	160	205
WELL PURPOSE: homes (home, irrigation, municipal, industrial)	sand	205	300
WELL COMPLETION DATA:	sandy shale	300	340
(1) diameter (inches) 4"	shale	340	378
(2) total depth (feet) 430'	Rock & shells	378	405
(3) static water level (feet) 190' below top of ground.	green sand & sandy shale	405	430
(4) casing PUC 360' (material) (depth)			
4" if telescope see back. (size)			
(5) screen (length) (depth to top)			
(size) (material)			
(6) pump 1 log pm (HP) (std gpm)			
(type power)			
(7) electric log (yes or no)			
(organization running log)			
(8) how well bottom plugged open			
DRILLERS REMARKS:			


DEPT. OF NATURAL RESOURCES  
BUREAU OF LAND & WATER RESOURCES

JUN 18 1980

RECEIVED

If well telescopes please sketch and show depths.

GROUND LEVEL

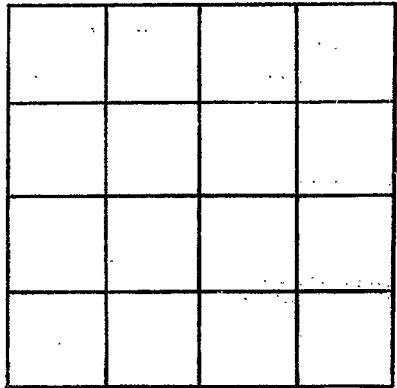

SECTION \_\_\_\_\_

Please indicate well location X.

ADDITIONAL INFORMATION

If more than one screen, show locations of each on sketch.