

Newton

MISSISSIPPI
BOARD OF WATER COMMISSIONERS
416 North State Street
Jackson, Mississippi 39201

K 2023
6-27-80
6-27-80

WATER WELL DRILLERS LOG

6-27-80 19 McDonalds Well Newton
date well completed firm name county well located

LANDOWNER: Jewel Tingle
RT# 1 Box 172-A1 Newton
(mailing address)

description of formations encountered	from	to
clay	0	15
thin layers of shale & clay	15	90

WELL LOCATION:
sec. 13 T 6 N R 11 E
1 miles S W of Newton
(distance) (direction) (nearest town)

description of formations encountered	from	to
course topped sand	90	110

WELL PURPOSE: normal
(home, irrigation, municipal, industrial)

- WELL COMPLETION DATA:
- (1) diameter (inches) 9"
 - (2) total depth (feet) 110'
 - (3) static water level (feet) 8' below top of ground.
 - (4) casing PVC, 105' (material) (depth)
9" (size) if telescope see back.
 - (5) screen 5' 105 to 110' (length) (depth to top)
9" (size) PVC (material)
 - (6) pump 1/2 HP, 6 gpm (HP) (y/d/gpm)
 - (type power) F
 - (7) electric log (yes or no)
 - (organization running log)
 - (8) how well bottom plugged water

DEPT. OF NATURAL RESOURCES
BUREAU OF LAND & WATER RESOURCES


JUL - 3 1980

RECEIVED

DRILLERS REMARKS:

If well telescopes please sketch and show depths.

GROUND LEVEL

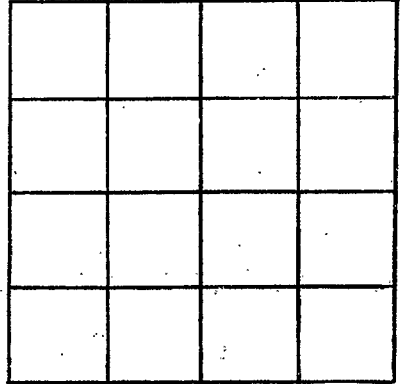

SECTION _____

Please indicate well location X.

ADDITIONAL INFORMATION

If more than one screen, show locations of each on sketch.