

Newton
R2025

MISSISSIPPI DEPARTMENT OF NATURAL RESOURCES

Bureau of Land and Water Resources

Southport Mall

P.O. Box 10631

Jackson, Mississippi 39209

WATER WELL DRILLERS LOG

11/27/
date well completed

1981 Jerry Dooling Co.
firm name

Newton
county well located

LANDOWNER:
Larry Lindsey
Rt 1 Newton Miss.
(mailing address)

description of formations encountered

from

to

<u>Yellow Clay</u>	<u>0</u>	<u>40</u>
<u>Sandy</u>	<u>40</u>	<u>80</u>
<u>Clay</u>	<u>80</u>	<u>130</u>
<u>Sand</u>	<u>130</u>	<u>150</u>

WELL LOCATION:

sec. 35 T 6 N R 4 E
S W
1/2 miles SE of Newton
(distance) (direction) (nearest town)

WELL PURPOSE:

(home, irrigation, municipal, industrial)

WELL COMPLETION DATA:

- (1) diameter (inches) 2"
- (2) total depth (feet) 150
- (3) static water level (feet) 100 below above top of ground.
- (4) casing 140 (material) (depth)
(size) if telescope see back.
- (5) screen 10', 140 (length) (depth to top)
2" PVC (size) (material)
- (6) pump 1 HP 4 (HP) (yield gpm)
jet (type power)
- (7) electric log NO (yes or no)

(organization running log)

(8) how well bottom plugged

DRILLERS REMARKS:


DEPT. OF NATURAL RESOURCES
BUREAU OF LAND & WATER RESOURCES

JUN 30 1982

RECEIVED

If well telescopes please sketch and show depths.

GROUND LEVEL

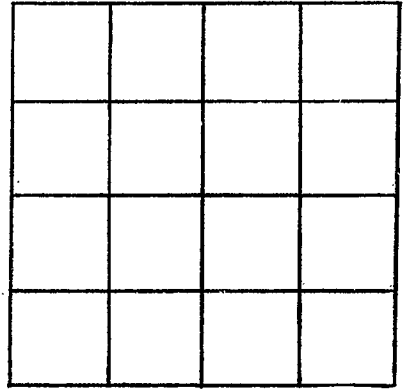

SECTION _____

Please indicate well location X.

ADDITIONAL INFORMATION

If more than one screen,
show locations of each on sketch.