

Newton
K 2026
2/16/81
9-16-81

MISSISSIPPI
 BOARD OF WATER COMMISSIONERS
 416 North State Street
 Jackson, Mississippi 39201

WATER WELL DRILLERS LOG


McDonald & Hill firm name Newton county well located
 date well completed

LANDOWNER:	description of formations encountered	from	to
<u>Leon Pugh</u>			
<u>#1 Newton</u> (mailing address)	<u>sandy shale</u>	<u>20</u>	<u>125</u>
WELL LOCATION: sec. <u>12-6</u> T <u>N</u> R <u>11</u> E <u>4</u> miles <u>N</u> of <u>Newton</u> (distance) (direction) (nearest town)	<u>shale</u>	<u>125</u>	<u>165</u>
WELL PURPOSE: <u>home</u> (home, irrigation, municipal, industrial)	<u>Rock & Shell</u>	<u>165</u>	<u>195</u>
WELL COMPLETION DATA: (1) diameter (inches) <u>4"</u>	<u>green sand</u>	<u>195</u>	<u>225</u>
(2) total depth (feet) <u>240'</u>			
(3) static water level (feet) <u>70'</u> below above top of ground.			
(4) casing <u>PVC</u> <u>180'</u> (material) (depth) <u>4"</u> (size) if telescope see back.			
(5) screen _____ (length) (depth to top) (size) (material)			
(6) pump <u>1/2</u> <u>800 gpm</u> (HP) (field gpm) (type power)			
(7) electric log _____ (yes or no) (organization running log)			
(8) how well bottom plugged <u>DPD</u>			
DRILLERS REMARKS:			

DEPT. OF NATURAL RESOURCES
 BUREAU OF LAND & WATER RESOURCES
 RECEIVED
 MAR - 2 1981

If well telescopes please sketch and show depths.

GROUND LEVEL

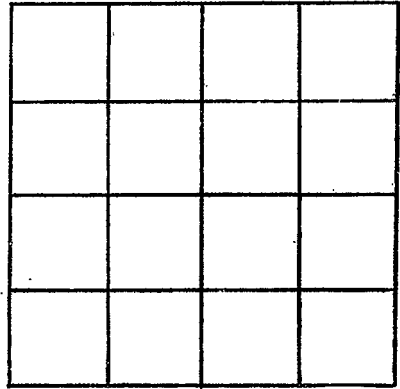

SECTION _____

Please indicate well location X.

ADDITIONAL INFORMATION

If more than one screen, show locations of each on sketch.