

MISSISSIPPI DEPARTMENT OF NATURAL RESOURCES

Bureau of Land and Water Resources

Southport Mall

P.O. Box 10631

Jackson, Mississippi 39209

WATER WELL DRILLERS LOG

Newton
K
2030

4-20-82 19 McDonald & Hill Newton
date well completed firm name county well located

LANDOWNER:	description of formations encountered	from	to
Sem Watson			
P.O. Box 514 Donahue (mailing address)	shale	50	65
WELL LOCATION: sec <u>3</u> T <u>6</u> N R <u>11</u> E S W <u>6</u> miles <u>N</u> of <u>Newton</u> (distance) (direction) (nearest town)	sandy shale & rock	65	160
	shale & sandy st.	160	220
	sand & shale	220	300
WELL PURPOSE: <u>home</u> (home, irrigation, municipal, industrial)	sandy shale	300	340
WELL COMPLETION DATA:	shale	340	381
(1) diameter (inches) <u>4"</u>	rock & shells	381	405
(2) total depth (feet) <u>440'</u>	medium sand & sandy shale	405	420
(3) static water level (feet) <u>185'</u> below top of ground.	sandy shale & rock	420	440
(4) casing <u>PVC 360'</u> (material) (depth) <u>4"</u> (size) if telescope see back.			
(5) screen (length) (depth to top) (size) (material)			
(6) pump <u>3/4</u> <u>8000</u> (HP) (yield gpm) <u>K</u> (type power)			
(7) electric log (yes or no) (organization running log)			
(8) how well bottom plugged <u>open</u>			

DRILLERS REMARKS:


DEPT OF NATURAL RESOURCES
BUREAU OF LAND & WATER RESOURCES

APR 27 1982

RECEIVED

If well telescopes please sketch and show depths.

GROUND LEVEL

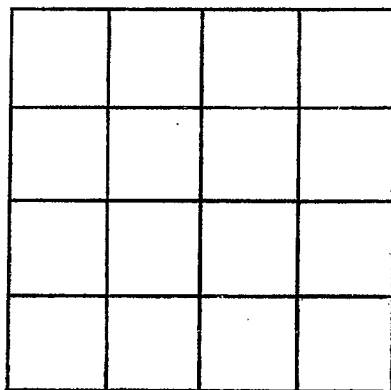

SECTION _____

Please indicate well location X.

ADDITIONAL INFORMATION

If more than one screen,
show locations of each on sketch.