

MISSISSIPPI DEPARTMENT OF NATURAL RESOURCES

Bureau of Land and Water Resources

Southport Mall

P.O. Box 10631

Jackson, Mississippi 39209

WATER WELL DRILLERS LOG

Newton  
K  
2032

10-20-82 date well completed     McDonald + Hill firm name     Newton county well located

LANDOWNER:	description of formations encountered	from	to
<u>Hilton Watkins</u>	<u>clay &amp; sand</u>	<u>0</u>	<u>23</u>
<u>#1 Box 75 Newton</u> (mailing address)	<u>shale</u>	<u>23</u>	<u>50</u>
WELL LOCATION:	<u>sandy shale</u>	<u>50</u>	<u>70</u>
sec. <u>24</u> T. <u>6</u> N. R. <u>11</u> E. S. W.	<u>shale &amp; sand</u>	<u>70</u>	<u>100</u>
<u>2</u> miles <u>N</u> of <u>Newton</u> (distance) (direction) (nearest town)	<u>shale</u>	<u>100</u>	<u>130</u>
WELL PURPOSE: <u>none</u> (home, irrigation, municipal, industrial)	<u>fine sand</u>	<u>130</u>	<u>220</u>
WELL COMPLETION DATA:	<u>sandy shale</u>	<u>220</u>	<u>260</u>
(1) diameter (inches) <u>4"</u>	<u>shale</u>	<u>260</u>	<u>291</u>
(2) total depth (feet) <u>360</u>	<u>Rock &amp; shells</u>	<u>291</u>	<u>323</u>
(3) static water level (feet) <u>100</u> below above top of ground.	<u>green sand</u>	<u>323</u>	<u>340</u>
(4) casing <u>PVC</u> <u>280'</u> (material) (depth)	<u>shale &amp; rock</u>		
<u>4"</u> (size) if telescope see back.			
(5) screen _____ (length) (depth to top)			
(size) _____ (material)			
(6) pump <u>3/4</u> <u>800 P.M.</u> (HP) (yield gpm)			
<u>F</u> (type power)			
(7) electric log _____ (yes or no)			
(organization running log)			
(8) how well bottom plugged <u>open</u>			

DEPT. OF NATURAL RESOURCES  
 BUREAU OF LAND & WATER RESOURCES


OCT 26 1982

RECEIVED

DRILLERS REMARKS:  
 \_\_\_\_\_  
 \_\_\_\_\_

If well telescopes please sketch and show depths.

GROUND LEVEL

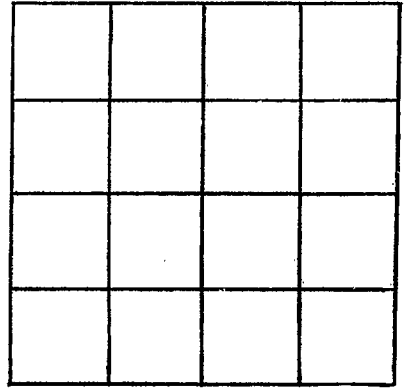

SECTION \_\_\_\_\_

Please indicate well location X.

ADDITIONAL INFORMATION

If more than one screen,  
show locations of each on sketch.