

MISSISSIPPI DEPARTMENT OF NATURAL RESOURCES

Bureau of Land and Water Resources

Southport Mall

P.O. Box 10631

Jackson, Mississippi 39209

WATER WELL DRILLERS LOG

Newton  
R2033

10-27-82 McDonald's Well Newton  
date well completed firm name county well located


LANDOWNER:	description of formations encountered	from	to
<u>Willie Graham</u>	<u>clay &amp; sand</u>	<u>0</u>	<u>10</u>
<u>Rt # 1 Box 35A, Newton</u> (mailing address)	<u>shale</u>	<u>10</u>	<u>60</u>
WELL LOCATION:	<u>sandy shale</u>	<u>60</u>	<u>100</u>
sec. <u>6</u> T. <u>6</u> N. R. <u>11</u> E	<u>shale &amp; ot sand</u>	<u>100</u>	<u>170</u>
<u>8</u> miles <u>SW</u> of <u>Newton</u> (distance) (direction) (nearest town)	<u>sand</u>	<u>170</u>	<u>285</u>
WELL PURPOSE: <u>none</u> (home, irrigation, municipal, industrial)	<u>sandy shale</u>	<u>285</u>	<u>325</u>
WELL COMPLETION DATA:	<u>shale</u>	<u>325</u>	<u>369</u>
(1) diameter (inches) <u>4"</u>	<u>Rock &amp; shells</u>	<u>369</u>	<u>400</u>
(2) total depth (feet) <u>420'</u>	<u>green sand</u>	<u>400</u>	<u>420</u>
(3) static water level (feet) <u>170'</u> below top of ground.			
(4) casing <u>PVC</u> <u>342</u> (material) (depth)			
<u>4"</u> (size) if telescope see back.			
(5) screen _____ (length) (depth to top)			
(size) _____ (material)			
(6) pump <u>3U</u> <u>8 gpm</u> (HP) (yield gpm)			
(type power) <u>F</u>			
(7) electric log _____ (yes or no)			
(organization running log) _____			
(8) how well bottom plugged <u>open</u>			

DRILLERS REMARKS:

MISSISSIPPI DEPARTMENT OF NATURAL RESOURCES  
BUREAU OF LAND AND WATER RESOURCES  
JACKSON, MISSISSIPPI 39209  
NOV-18 1982  
**RECEIVED**

If well telescopes please sketch and show depths.

GROUND LEVEL

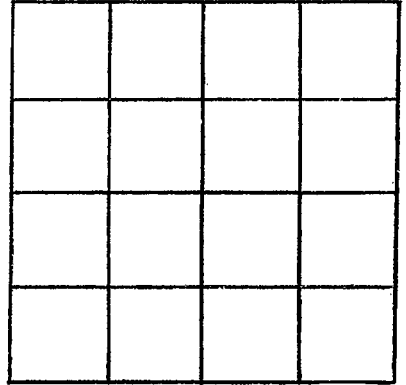

SECTION \_\_\_\_\_

Please indicate well location X.

ADDITIONAL INFORMATION

If more than one screen, show locations of each on sketch.