

Newton  
K  
234

MISSISSIPPI DEPARTMENT OF NATURAL RESOURCES  
 Bureau of Land and Water Resources  
 Southport Mall  
 P.O. Box 10631  
 Jackson, Mississippi 39209  
**WATER WELL DRILLERS LOG**

3-15-83  
 date well completed

McDonald & Hill  
 firm name

Newton  
 county well located

**LANDOWNER:**  
Doyle Jordan  
Newton  
 (mailing address)

**WELL LOCATION:**  
 sec. 26T 6N R. 11E  
1 miles N of Newton  
 (distance) (direction) (nearest town)

**WELL PURPOSE:** home  
 (home, irrigation, municipal, industrial)

- WELL COMPLETION DATA:**
- (1) diameter (inches) 4"
  - (2) total depth (feet) 300'
  - (3) static water level (feet) 78 below  
 top of ground.
  - (4) casing PVC 240'  
 (material) (depth)  
4"  
 (size) if telescope see back.
  - (5) screen \_\_\_\_\_  
 (length) (depth to top)  
 (size) (material)
  - (6) pump 1/2 300pm  
 (HP) (yield' gpm)  
E  
 (type power)
  - (7) electric log yes  
 (yes or no)  
 (organization running log)
  - (8) how well bottom plugged open

description of formations encountered	from	to
<u>clay</u>	<u>0</u>	<u>16</u>
<u>shale</u>	<u>16</u>	<u>20</u>
<u>sand</u>	<u>20</u>	<u>140</u>
<u>sand &amp; shale</u>	<u>140</u>	<u>180</u>
<u>sand, shale</u>	<u>180</u>	<u>220</u>
<u>shale</u>	<u>220</u>	<u>250</u>
<u>rock &amp; shells</u>	<u>250</u>	<u>285</u>
<u>green sand</u>	<u>285</u>	<u>300</u>

DEPT. OF NATURAL RESOURCES  
 BUREAU OF LAND & WATER RESOURCES


MAR 21 1983

RECEIVED

**DRILLERS REMARKS:**

If well telescopes please sketch and show depths.

GROUND LEVEL

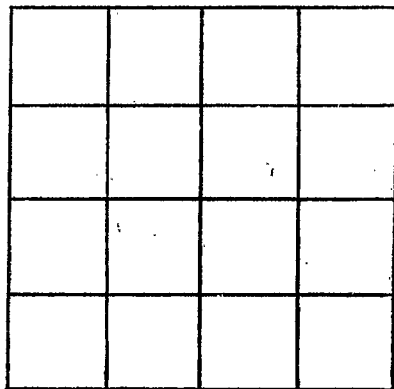

SECTION \_\_\_\_\_

Please indicate well location X.

ADDITIONAL INFORMATION

If more than one screen,  
show locations of each on sketch.