

MISSISSIPPI DEPARTMENT OF NATURAL RESOURCES

Bureau of Land and Water Resources

Southport Mall

P.O. Box 10631

Jackson, Mississippi 39209

WATER WELL DRILLERS LOG

Newton
K
2036

6/12/83
date well completed

Jerry Drilling Co.
firm name

Newton
county well located


LANDOWNER:	description of formations encountered	from	to
James Buckley Rt 2, Newton, Miss (mailing address)			
WELL LOCATION:			
sec <u>36</u> T <u>6</u> N R <u>11</u> E S W			
<u>3</u> miles <u>SE</u> of <u>Newton</u> (distance) (direction) (nearest town)			
WELL PURPOSE: (home, irrigation, municipal, industrial)			
WELL COMPLETION DATA:			
(1) diameter (inches) <u>2"</u>			
(2) total depth (feet) <u>180'</u>			
(3) static water level (feet) <u>120'</u> ^{below} above top of ground.			
(4) casing <u>PVC</u> , <u>180'</u> (material) (depth)			
_____ if telescope see back. (size)			
(5) screen <u>2"</u> , <u>175'</u> (length) (depth to top)			
<u>2"</u> , <u>PVC</u> (size) (material)			
(6) pump <u>1 1/2</u> <u>5</u> (HP) (yield gpm)			
<u>Jet</u> (type power)			
(7) electric log _____ (yes or no)			
_____ (organization running log)			
(8) how well bottom plugged <u>Wash</u> <u>Value</u>			
DRILLERS REMARKS:			

DEPT. OF NATURAL RESOURCES
BUREAU OF LAND & WATER RESOURCES

AUG 13 1984
RECEIVED

If well telescopes please sketch and show depths.

GROUND LEVEL

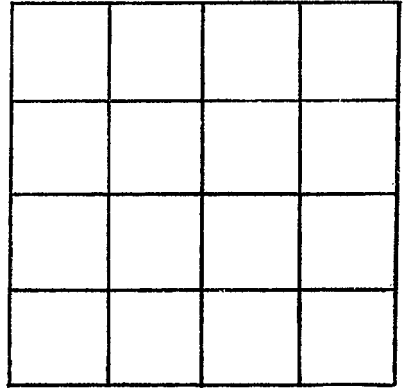

SECTION _____

Please indicate well location X.

ADDITIONAL INFORMATION

If more than one screen, show locations of each on sketch.