

MISSISSIPPI DEPARTMENT OF NATURAL RESOURCES

Bureau of Land and Water Resources

Southport Mall

P.O. Box 10631

Jackson, Mississippi 39209

WATER WELL DRILLERS LOG

Newton  
K  
237

7-18-83, 19 McDonald Hill Newton  
date well completed firm name county well located

LANDOWNER:	description of formations encountered	from	to
<u>Eal Scoggin</u> <u>Newton</u> (mailing address)			
	<u>sand &amp; lignite</u>	<u>18</u>	<u>160</u>
	<u>shale</u>		

WELL LOCATION:  
sec. 13 T 6 N S R 11 E W  
1 miles N of Newton  
(distance) (direction) (nearest town)

WELL PURPOSE: home  
(home, irrigation, municipal, industrial)

- WELL COMPLETION DATA:
- (1) diameter (inches) 9"
  - (2) total depth (feet) 160'
  - (3) static water level (feet) 18' below above top of ground.
  - (4) casing PVC 145'  
(material) (depth)  
9"  
(size) if telescope see back.
  - (5) screen 15 145 to 160'  
(length) (depth to top)  
9" PVC  
(size) (material)
  - (6) pump 1/2 600 gpm  
(HP) (yield gpm)  
F  
(type power)
  - (7) electric log —  
(yes or no)  
(organization running log)
  - (8) how well bottom plugged value

DRILLERS REMARKS:


DEPT. OF NATURAL RESOURCES  
BUREAU OF LAND & WATER RESOURCES

JUL 25 1983

RECEIVED

If well telescopes please  
sketch and show depths.

GROUND LEVEL

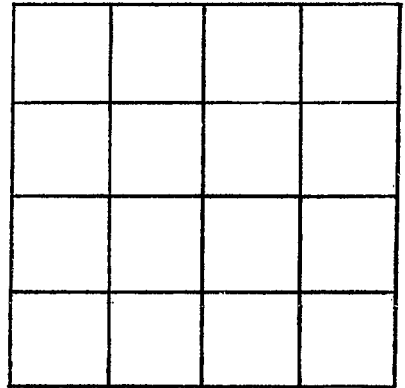

SECTION \_\_\_\_\_

Please indicate well location X.

ADDITIONAL INFORMATION

If more than one screen,  
show locations of each on sketch.