

MISSISSIPPI DEPARTMENT OF NATURAL RESOURCES

Bureau of Land and Water Resources

Southport Mall

P.O. Box 10631

Jackson, Mississippi 39209

WATER WELL DRILLERS LOG

Newton
R
2038

8-18-83 date well completed McDonald's Well firm name Newton county well located

LANDOWNER:	description of formations encountered	from	to
Dan Griffin	clay	0	10
Rt# 1 Newton (mailing address)	sand	10	40
WELL LOCATION:	shale	40	60
sec. 3 T. 16 N. R. 11 E. S W	sandy shale & shells	60	100
5 miles N of Newton (distance) (direction) (nearest town)	shale & sand	100	180
WELL PURPOSE: home (home, irrigation, municipal, industrial)	sand & shale	180	270
WELL COMPLETION DATA:	sandy shale	270	300
(1) diameter (inches) 4"	shale	300	340
(2) total depth (feet) 380'	rock & shells	340	360
(3) static water level (feet) 190' below top of ground.	green sandy sandy shale	360	380
(4) casing PUC 324' (material) (depth)			
4" if telescope see back. (size)			
(5) screen _____ (length) (depth to top)			
(size) (material)			
(6) pump 1 9000 (HP) (yield gpm)			
(type power) F			
(7) electric log _____ (yes or no)			
(organization running log)			
(8) how well bottom plugged open			
DRILLERS REMARKS:			


DEPT. OF NATURAL RESOURCES
BUREAU OF LAND & WATER RESOURCES

AUG 23 1983

RECEIVED

If well telescopes please
sketch and show depths.

GROUND LEVEL

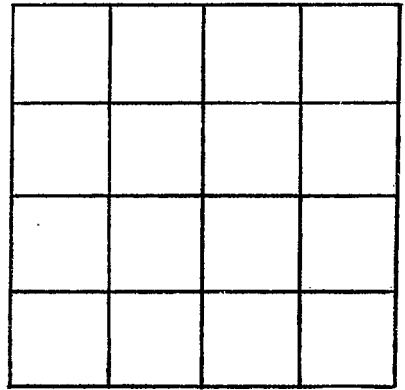

SECTION _____

Please indicate well location X.

ADDITIONAL INFORMATION

If more than one screen,
show locations of each on sketch.