

MISSISSIPPI DEPARTMENT OF NATURAL RESOURCES

Bureau of Land and Water Resources

Southport Mall

P.O. Box 10631

Jackson, Mississippi 39209

WATER WELL DRILLERS LOG

Newton
K
2039

1-13-84 19 McDonald & Hill Newton
 date well completed firm name county well located


LANDOWNER:	description of formations encountered	from	to
Iroy Kelly Rt #1 Decatur (mailing address)	clay + sand	0	25
	shale	25	40
WELL LOCATION:	sandy shale + shells	40	125
sec. 3 T 6 N R 11 E S W	shale + sand	125	190
8 miles SW of Decatur (distance) (direction) (nearest town)	concrete	190	280
WELL PURPOSE: home (home, irrigation, municipal, industrial)	sandy shale	280	315
WELL COMPLETION DATA:	shale	315	350
(1) diameter (inches) 4"	rock & shells	350	380
(2) total depth (feet) 420'	green sand & shells	380	400
(3) static water level (feet) 200' below top of ground.	shale		
(4) casing PVC 300' (material) (depth)	shale + sand & rock	400	430
2" if telescope see back. (size)			
(5) screen (length) (depth to top)			
(size) (material)			
(6) pump 3/4 HP 9500M (HP) (yield gpm)			
K (type power)			
(7) electric log (yes or no)			
(organization running log)			
(8) how well bottom plugged down			
DRILLERS REMARKS:			

DEPT. OF NATURAL RESOURCES
 BUREAU OF LAND & WATER RESOURCES

RECEIVED
 JAN 28 1984

If well telescopes please
sketch and show depths.

GROUND LEVEL

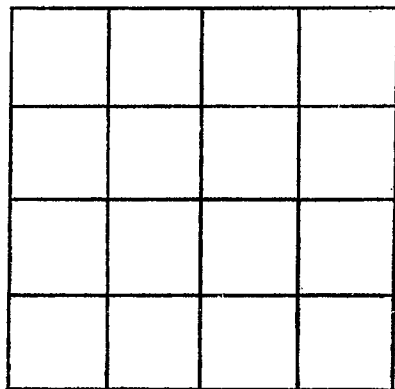

SECTION _____

Please indicate well location X.

ADDITIONAL INFORMATION

If more than one screen,
show locations of each on sketch.