

Newton  
K  
2040

MISSISSIPPI DEPARTMENT OF NATURAL RESOURCES  
Bureau of Land and Water Resources  
Southport Mall  
P.O. Box 10631  
Jackson, Mississippi 39209  
WATER WELL DRILLERS LOG

5-3-84 19 McDonald & Hill Newton  
date well completed firm name county well located

LANDOWNER:	description of formations encountered	from	to
Sophia Watkins Pt #1 Box 293 Newton (mailing address)			
WELL LOCATION:	shale	20	40
sec. 13 T 6 N R 11 E S W	sandy shale	40	70
2 miles N of Newton (distance) (direction) (nearest town)	sand	70	210
WELL PURPOSE: chemo. (home, irrigation, municipal, industrial)	sandy shale	210	250
WELL COMPLETION DATA:	shale	250	282
(1) diameter (inches) 4"	Rocky shale	282	310
(2) total depth (feet) 320	green sand	310	320
(3) static water level (feet) 115' below top of ground.			
(4) casing PVC, 265' (material) (depth) 4" if telescope see back. (size)			
(5) screen (length) (depth to top) (size) (material)			
(6) pump 3/4 HP 800 gpm (HP) (yield gpm) K (type power)			
(7) electric log (yes-or no) (organization running log)			
(8) how well bottom plugged Open			
DRILLERS REMARKS:			


DEPT. OF NATURAL RESOURCES  
BUREAU OF LAND & WATER RESOURCES

MAY -7 1984

RECEIVED

If well telescopes please sketch and show depths.

GROUND LEVEL

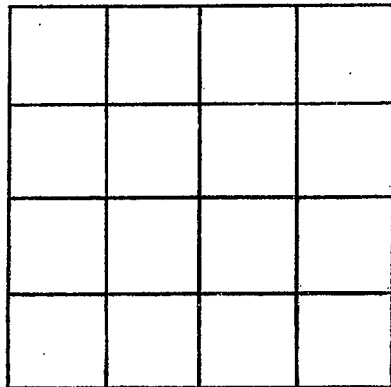

SECTION \_\_\_\_\_

Please indicate well location X.

ADDITIONAL INFORMATION

If more than one screen, show locations of each on sketch.