

MISSISSIPPI DEPARTMENT OF NATURAL RESOURCES

Bureau of Land and Water Resources

Southport Mall

P.O. Box 10631

Jackson, Mississippi 39209

WATER WELL DRILLERS LOG

NEWTON
K 2041

6.24.83
date well completed

McDONALD & Hill
firm name

NEWTON
county well located

LANDOWNER: EDGAR POOLE JR
R#1 BOX 295
NEWTON MS
(mailing address)

description of formations encountered	from	to
CLAY	0	18
SHALE	18	50
SAND ST SHALE	50	202
SHALE ST SAND	202	240
SHALE	240	268
ROCK ST SAND	268	290
SAND ST SHALE	290	300
POURSE SAND	300	310
SAND	310	320

WELL LOCATION:
sec. 13 T. 6 N R. 11 E
S W
2 miles N of NEWTON
(distance) (direction) (nearest town)

WELL PURPOSE: HOME
(home, irrigation, municipal, industrial)

- WELL COMPLETION DATA:
- (1) diameter (inches) 4"
 - (2) total depth (feet) 320'
 - (3) static water level (feet) 98' below top of ground.
 - (4) casing DUC 248'
(material) (depth)
4"
(size) if telescope see back.
 - (5) screen _____
(length) (depth to top)
(size) (material)
 - (6) pump _____
(HP) (yield gpm)
(type power)
 - (7) electric log _____
(yes or no)
(organization running log)
 - (8) how well bottom plugged open

RECEIVED


JUL 5 - 1985

Department of Natural Resources
Bureau of Land & Water Resources

DRILLERS REMARKS:

If well telescopes please sketch and show depths.

GROUND LEVEL

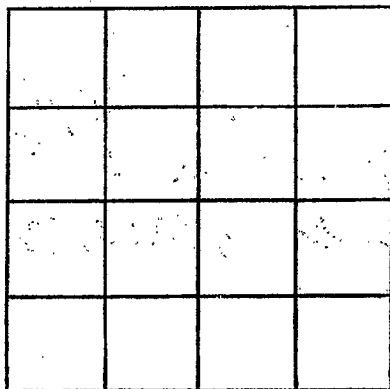

SECTION _____

Please indicate well location X.

ADDITIONAL INFORMATION

If more than one screen, show locations of each on sketch.