

MISSISSIPPI DEPARTMENT OF NATURAL RESOURCES
Bureau of Land and Water Resources
 Southport Mall
 P.O. Box 10631
 Jackson, Mississippi 39209
WATER WELL DRILLERS LOG

K 2643
NEWTON
10-16-85

10-16-85 19 MCDONALD & DILL NEWTON
 date well completed firm name county well located

LANDOWNER: Walter JACKSON
R#1 NEWTON MS

description of formations encountered	from	to
CLAY	0	28
SHALE SANDS ST	28	80
BROWN SHALE	80	100
SAND	100	230
SHALE SANDS	230	270
MED SHALE	270	305
ROCK ST SHALE	305	340
GREEN SAND	340	370
ST SHALE		

(mailing address)
 WELL LOCATION:
 sec. 22 T 6 N R 11 E
 S W
2 miles NW of NEWTON
 (distance) (direction) (nearest town)

WELL PURPOSE: HOME
 (home, irrigation, municipal, industrial)

- WELL COMPLETION DATA:
- diameter (inches) 4"
 - total depth (feet) 370'
 - static water level (feet) 105' below above top of ground.
 - casing PVC, 280'
 (material) (depth)
4"
 (size) if telescope see back.
 - screen _____
 (length) (depth to top)

 (size) (material)
 - pump _____
 (HP) (yield gpm)

 (type power)
 - electric log _____
 (yes or no)

 (organization running log)
 - how well bottom plugged OPEN

DRILLERS REMARKS: _____


RECEIVED

OCT 21 1985

Department of Natural Resources
 Bureau of Land & Water Resources

If well telescopes please sketch and show depths.

GROUND LEVEL

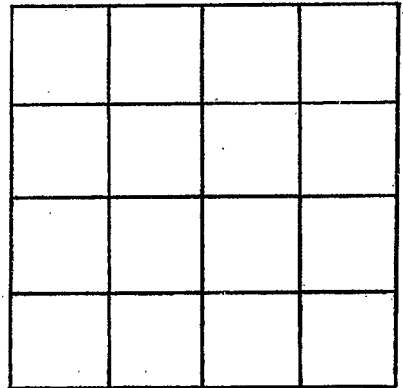

SECTION _____

Please indicate well location X.

ADDITIONAL INFORMATION

If more than one screen,
show locations of each on sketch.