

Newton
K 2045

MISSISSIPPI DEPARTMENT OF NATURAL RESOURCES
Bureau of Land and Water Resources
Southport Mall
P.O. Box 10631
Jackson, Mississippi 39209
WATER WELL DRILLERS LOG

4.26.86 19 McDONALD WELL NEWTON
date well completed firm name county well located

LANDOWNER:
MARTIN CARROL
NEWTON MS
(mailing address)

WELL LOCATION:
sec 23 T 6 N R 11 E
S W
1/2 miles NORTH of NEWTON
(distance) (direction) (nearest town)

WELL PURPOSE: HOME
(home, irrigation, municipal, industrial)

WELL COMPLETION DATA:

- (1) diameter (inches) 4"
- (2) total depth (feet) 400'
- (3) static water level (feet) 95' below top of ground.
- (4) casing PVC 320'
(material) (depth)
4"
(size) if telescope see back.
- (5) screen _____
(length) (depth to top)

(size) (material)
- (6) pump _____
(HP) (yield gpm)

(type power)
- (7) electric log _____
(yes or no)

(organization running log)
- (8) how well bottom plugged OPEN

description of formations encountered	from	to
<u>PLAY</u>	<u>0</u>	<u>10</u>
<u>SANDY ST SHELLS</u>	<u>10</u>	<u>50</u>
<u>SHALE</u>	<u>50</u>	<u>160</u>
<u>COURSE SAND</u>	<u>160</u>	<u>225</u>
<u>SANDY ST SHALE</u>	<u>225</u>	<u>290</u>
<u>SHALE</u>	<u>290</u>	<u>328</u>
<u>ROCK ST SAND</u>	<u>328</u>	<u>350</u>
<u>SAND ST ROCK</u>	<u>350</u>	<u>400</u>


RECEIVED
MAY - 5 1986

Department of Natural Resources
Bureau of Land & Water Resources

DRILLERS REMARKS:

If well telescopes please sketch and show depths.

GROUND LEVEL

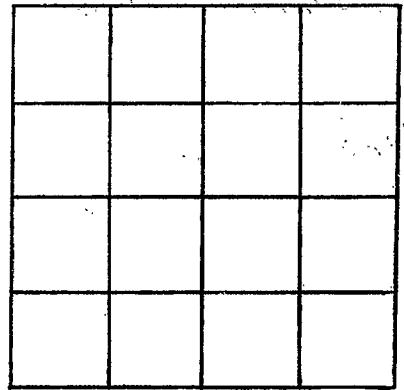

SECTION _____

Please indicate well location X.

ADDITIONAL INFORMATION

If more than one screen,
show locations of each on sketch.