

NEWTON
K 2047

MISSISSIPPI DEPARTMENT OF NATURAL RESOURCES

Bureau of Land and Water Resources

Southport Mall

P.O. Box 10631

Jackson, Mississippi 39209

WATER WELL DRILLERS LOG

2/27/1985 date well completed
 Jerry Drilling Co firm name
 Newton county well located

LANDOWNER:
 L. J. Banner
 Rta, Newton, Miss
 (mailing address)

description of formations encountered	from	to
Yellow Clay	0	30
Sandy Clay	30	120
Sandy Clay	120	220
Sandy Clay	220	260
Sandy Clay	260	380
Sandy	380	460

WELL LOCATION:
 sec. 2 T 6 N R 11 E
 8 S W
 8 miles (distance) NW of Newton (nearest town)

WELL PURPOSE:
 (home, irrigation, municipal, industrial)

WELL COMPLETION DATA:

(1) diameter (inches) 4"

(2) total depth (feet) 460

(3) static water level (feet) 210 below top of ground

(4) casing PVC 280 (material) (depth)

(size) If telescope see back.

(5) screen (length) (depth to top)

(size) (material)

(6) pump 3/4 (HP) 6-8 (yield gpm)
 Sub. (type power)

(7) electric log (yes or no)
 (organization running log)

(8) how well bottom plugged open




SEP 19 1986

Department of Natural Resources
 Bureau of Land & Water Resources

DRILLERS REMARKS:

If well telescopes please sketch and show depths.

GROUND LEVEL

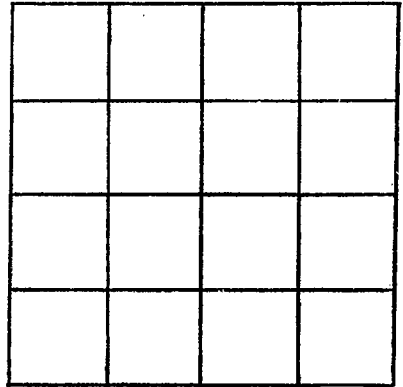

SECTION _____

Please indicate well location X.

ADDITIONAL INFORMATION

If more than one screen,
show locations of each on sketch.