

MISSISSIPPI DEPARTMENT OF ENVIRONMENTAL QUALITY
Bureau of Land and Water Resources

P. O. Box 10631
Jackson, MS 39289-0631
WATER WELL DRILLERS LOG

COUNTY WELL LOCATED <i>Newton</i>		PERMIT NUMBER	
WELL NUMBER <i>X 2068</i>	CODED	NAME OF DRILLING FIRM <i>McDonald & Dell</i>	
DATE WELL COMPLETED <i>6/17/92</i>		<i>Indn. Miss.</i>	

NAME & MAILING ADDRESS OF LANDOWNER <i>Alice Jones</i>			
<i>Rt 1 Box 156</i>			
<i>Newton, Miss. 39345</i>			
WELL LOCATION:	SEC	TOWNSHIP	RANGE
	<i>15</i>	<i>6</i>	<i>N 11 E</i>
		<i>S</i>	<i>W</i>
DISTANCE	DIRECTION	NEAREST TOWN	
<i>2 1/2</i> Miles	<i>NW</i>	<i>Newton</i>	
OTHER LANDMARK			
WELL PURPOSE: <input checked="" type="checkbox"/> Home <input type="checkbox"/> Irrigation, Municipal, Industrial, Fish Pond, etc.			

PUMP DATA			
PUMP TYPE (Circle One): <input checked="" type="radio"/> Submersible <input type="radio"/> Turbine <input type="radio"/> Jet <input type="radio"/> Flowing Well, Other (Describe) _____			
POWER TYPE (Circle One): <input checked="" type="radio"/> Electric <input type="radio"/> Tractor, Diesel, Gasoline, Butane, Other (Describe) _____ H/P _____			
Pump Capacity (GPM)	No. of Stages	Setting Depth	
<i>8</i>	<i>10</i>	<i>140</i> FT.	
PUMP TEST			
Well yielded <i>85</i> GPM with a drawdown of <i>20</i> ft. after <i>2</i> hours of pumping			

WELL DATA			
Well Depth	Casing Diameter (In.)	Casing Length (Ft.)	
<i>336</i>	<i>4</i>	<i>263'</i>	
Type of Casing	Hole Depth	Depth to Static Water Level	
<i>pvc</i>	<i>263</i>	<i>115'</i>	
TYPE OF COMPLETION: (Circle One or More): Gravel Packed, Underreamed, Telescoped, Natural Development, <input checked="" type="radio"/> Open Hole, Other			
Top of Lap Pipe or Reduction in Casing			
FEET <input type="checkbox"/> IF TELESCOPED OR MORE THAN ONE SCREEN: USE BACK PAGE			

LOG DATA	
TYPE OF LOG RUN (Circle One): <input type="radio"/> No Log Run, Electric, Gamma Ray, Density, Sonic, Neutron, Other (Describe) _____	
Name of Organization Running Log	

SCREEN DATA		
Diameter - Inches	Length - Feet	Slot Size - Inches
Screen Type	Depth to Bottom - Feet	

GEOLOGIC DATA (Office Use Only)			
Surface Elev.	Geologic Unit	Unit Thickness	Depth to Top
Subs. SWL	Date	Analysis	Aquifer Test

Driller's Remarks


DESCRIPTION OF FORMATIONS ENCOUNTERED	FROM	TO	FORMATIONS (Continued)	FROM	TO
<i>Clay</i>	<i>0</i>	<i>21</i>	<div style="font-size: 2em; font-weight: bold; border: 2px solid black; padding: 5px; display: inline-block;">RECEIVED</div> <div style="font-size: 1.5em; font-weight: bold;">JUL 10 1992</div>		
<i>Sandy Shale</i>	<i>21</i>	<i>112</i>			
<i>Sand</i>	<i>112</i>	<i>235</i>			
<i>Sandy Shale</i>	<i>235</i>	<i>253</i>			
<i>Shale</i>	<i>253</i>	<i>294</i>			
<i>Rock - s + sand</i>	<i>294</i>	<i>317</i>			
<i>Sand - Isuan</i>	<i>317</i>	<i>333</i>			
<i>Shale</i>	<i>333</i>	<i>336</i>			

Dept. of Environmental Quality
Bureau of Land & Water Resources

IF MORE SPACE IS NEEDED, USE BACK

If well telescopes please
sketch and show depths.

GROUND LEVEL

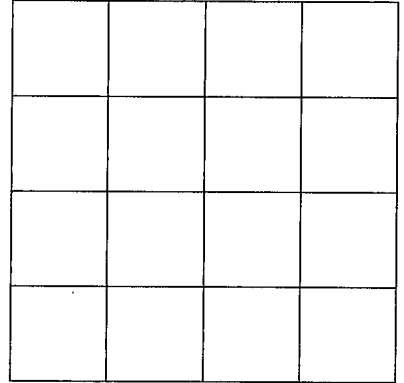

SECTION _____

Please indicate well location X.

ADDITIONAL INFORMATION

If more than one screen,
show location of each on sketch.