

3 NEWTON

8

L 12
2-21-63


WATER WELL DRILLERS LOG

Date: 2-21, 1963, Driller: J. R. Welch County Newton
(Name)

	Description & Color of Materials Sand, Clay, Red Clay, Shell, etc.	Thick- ness Feet	Depth Feet
(1) Owner of Land: <u>Mrs. MAVIS HOLT</u> (Name)	<u>B. clay</u>	<u>11</u>	<u>0-11</u>
<u>Hickory</u> (Address)	<u>Dark clay</u>	<u>32</u>	<u>11-43</u>
(2) Location: <u>SE 1/4, SE 1/4, Sec. 12 T. 6 R. 12</u>	<u>Blue</u>	<u>53</u>	<u>43-95</u>
<u>3</u> miles <u>N</u> , of <u>Hickory</u> (distance) (direction) (Nearest Town)	<u>Blue & heavy</u>	<u>149</u>	<u>95-244</u>
(3) Topography: <input checked="" type="checkbox"/> (Hilly) <input type="checkbox"/> (Flat) <input type="checkbox"/> (Level)	<u>Sand</u>	<u>31</u>	<u>244</u>
(4) Purpose of Well: <u>Domestic</u> (Domestic Irrigation Municipal, Industrial, Other)			<u>275</u>

Information upon completion of well:

- (1) Diameter 2" inches.
 - (2) Total Depth 275 feet.
 - (3) Water Level 80 feet below top of ground.
 - (4) Cased to 105, Size 2"
 - (5) Screen: Size none, Length _____
 - (6) Were any formations sealed against pollution?
_____ yes, no.
- If YES depth of formation _____
- Why _____
- Drillers Remarks: Open Hole

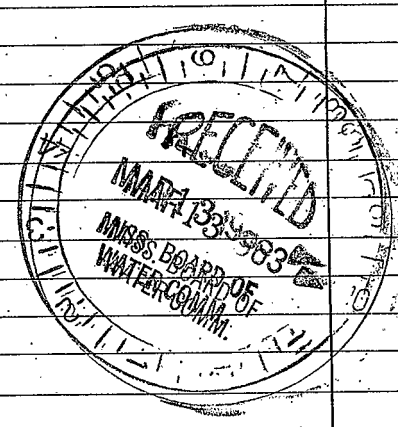

2

58

Well No.

(Use Back Side)

