

L13
6-11-62

WATER WELL DRILLERS LOG

Date: 6-11, 1962, Driller: U. L. Shelton County Newton
(Name)

- (1) Owner of Land: J. Lopez
(Name)
Hiboy Miss
(Address)
- (2) Location: NW 1/4, SE 1/4, Sec 35 T6R1E
1 miles West, of Hiboy
(distance) (direction) (Nearest Town)
- (3) Topography: (Hilly) (Flat) (Level)
- (4) Purpose of Well: Domestic
(Domestic Irrigation
Municipal, Industrial, Other)

Description & Color of Materials
Sand, Clay, Red Clay, Shell, etc.

Thick-
ness
Feet

Depth
Feet

Clay 20 0-20
Sand 60 20-80


Information upon completion of well:

- (1) Diameter 3 1/2 inches.
- (2) Total Depth 80 feet.
- (3) Water Level 9 feet below top of ground.
- (4) Cased to 80, Size 2"
- (5) Screen: Size 2", Length 6
- (6) Were any formations sealed against pollution?
_____ yes, no.

If YES depth of formation _____

Why _____

Drillers Remarks: _____

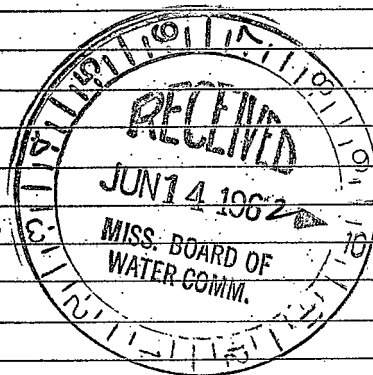

(Use Back Side)

Well No. 48

[The page contains extremely faint and illegible text, likely bleed-through from the reverse side of the document. The text is scattered across the page and does not form any recognizable words or sentences.]