

KL15  
5-16-61

N 300

WATER WELL DRILLERS LOG

Date: 5-16, 1961, Driller: U. L. Wedder, Newton County, Newton  
(Name)


	Description & Color of Materials Sand, Clay, Red Clay, Shell, etc.	Thick- ness Feet	Depth Feet
(1) Owner of Land: <u>C. Lancaster</u> (Name) <u>Laurene Miss.</u> (Address)	Clay	15	0-15
(2) Location: <u>SW 1/4, SE 1/4, Sec. 30 T. 12 R. 11</u> <u>4</u> miles <u>East</u> of <u>Newton</u> (distance) (direction) (Nearest Town)	Blue clay Sandy W Sand	18 33	15-43 43-76 76-108
(3) Topography: <input checked="" type="checkbox"/> (Hilly) <input type="checkbox"/> (Flat) <input type="checkbox"/> (Level)			
(4) Purpose of Well: <u>Domestic</u> (Domestic Irrigation Municipal, Industrial, Other)			

Information upon completion of well:

- (1) Diameter 2 inches.
- (2) Total Depth 108 feet.
- (3) Water Level 40 feet below top of ground.
- (4) Cased to 108, Size 2"
- (5) Screen: Size #20, Length 10'
- (6) Were any formations sealed against pollution?  
\_\_\_\_\_ yes,  no.

If YES depth of formation \_\_\_\_\_  
Why \_\_\_\_\_

Drillers Remarks: \_\_\_\_\_

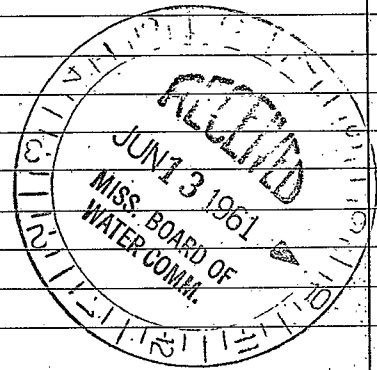

(Use Back Side)

Well No. 15

