

NEWTON

WATER WELL DRILLERS LOG

L 16
4-12-63

Date: 4/12/63, 1963, Driller: M. A. Donald Hill County Newton

(Name)

(1) Owner of Land: John STREBOK
(Name)
Hickory, Miss
(Address)

Description & Color of Materials Sand, Clay, Red Clay, Shell, etc.	Thick- ness Feet	Depth Feet
Clay	0	10
SAND	10	35
Blue Clay	35	88
Clay ST Rock	88	115
Clay	115	245
SAND No 16	245	270

(2) Location: 1/4, 1/4, Sec. 12 T6 R12
4 miles NORTH of Hickory
(distance) (direction) (Nearest Town)

(3) Topography: X
(Hilly) (Flat) (Level)

(4) Purpose of Well: DOMESTIC
(Domestic Irrigation
Municipal, Industrial, Other)

Information upon completion of well:

(1) Diameter 4" inches.

(2) Total Depth 270 feet.

(3) Water Level 48' feet below top of ground.
150' 4"

(4) Cased to 126", Size 2"


(5) Screen: Size 2", Length 4" STEEL

(6) Were any formations sealed against pollution?
yes, no.

If YES depth of formation

Why

Drillers Remarks:

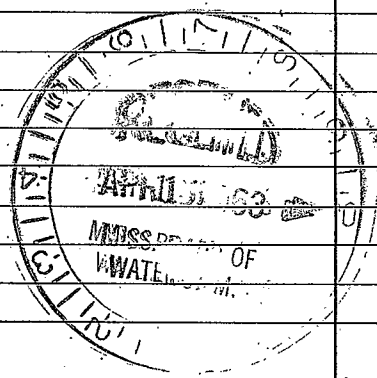

(Use Back Side)

Well No.

