

L 18

6-1-63

WATER WELL DRILLERS LOG

Date: 6-1, 1963, Driller: W. D. Sheldony Newton  
 (Name)

(1) Owner of Land: J. G. Craig  
 (Name)  
Hickory Miss  
 (Address)

(2) Location: N 1/2 1/4, NE 1/4, Sec 23 T6 R12  
2 miles North, of Hickory  
 (distance) (direction) (Nearest Town)

(3) Topography:  (Hilly)  (Flat)  (Level)

(4) Purpose of Well: Domestic  
 (Domestic Irrigation  
 Municipal, Industrial, Other)

Description & Color of Materials  
 Sand, Clay, Red Clay, Shell, etc.

Thick-  
ness  
Feet

Depth  
Feet

<u>R clay</u>	<u>12</u>	<u>0-12</u>
<u>G clay</u>	<u>28</u>	<u>12-40</u>
<u>Sand</u>	<u>55</u>	<u>40-95</u>

Information upon completion of well:

(1) Diameter 4" inches.

(2) Total Depth 95 feet.

(3) Water Level 35 feet below top of ground.

(4) Cased to 95, Size 4"


(5) Screen: Size 2", Length 6'

(6) Were any formations sealed against pollution?  
 \_\_\_\_\_ yes,  no.

If YES depth of formation \_\_\_\_\_

Why \_\_\_\_\_

Drillers Remarks: \_\_\_\_\_

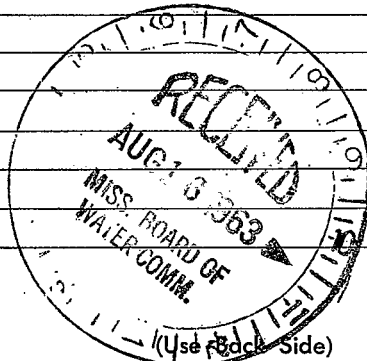

66

Well No.

