

L 20

WATER WELL DRILLERS LOG

9-23-63

Date: 9-29, 1963, Driller: H. L. Welch County Newton
(Name)

(1) Owner of Land: Tommy Sanders
(Name)
Newton, Miss.
(Address)

(2) Location: SE 1/4, NW 1/4, Sec 28 T6 R12
4 miles E of Newton
(distance) (direction) (Nearest Town)

(3) Topography: Hilly
(Hilly) (Flat) (Level)

(4) Purpose of Well: Domestic
(Domestic Irrigation, Municipal, Industrial, Other)

Information upon completion of well:

(1) Diameter 3 1/2 inches.

(2) Total Depth 157 feet.

(3) Water Level 40 feet below top of ground.

(4) Cased to 157, Size 2"

(5) Screen: Size 2", Length 10'


(6) Were any formations sealed against pollution?
___ yes, no.

If YES depth of formation _____

Why _____

Drillers Remarks: _____

Description & Color of Materials Sand, Clay, Red Clay, Shell, etc.	Thick- ness Feet	Depth Feet
<u>Clay</u>	<u>32</u>	<u>0-32</u>
<u>Sand</u>	<u>125</u>	<u>32-157</u>

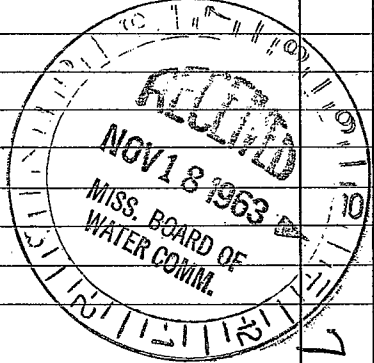

3

(Use Back Side)

77

Well No.

