

L 22
10-22-63

WATER WELL DRILLERS LOG

Date: 10-22, 1963, Driller: Mr. Daniel Rice, County Newton
(Name)


- (1) Owner of Land: G E Paraway
(Name)
Hickory, Miss.
(Address)
- (2) Location: 1/4, 1/4, Sec. 35 T 6N R 12E
1 miles W, of Newton,
(distance) (direction) (Nearest Town)
- (3) Topography: Hilly
(Hilly) (Flat) (Level)
- (4) Purpose of Well: Domestic
(Domestic Irrigation
Municipal, Industrial, Other)

Description & Color of Materials Sand, Clay, Red Clay, Shell, etc.	Thick- ness Feet	Depth Feet
Play	0	12
sh-1	12	18
clay	14	20
shale	20	23
chall	23	40
sl. shale & chall	40	47
sl	47	105
sl. shale	105	115
shale	115	148
lime shale & lime	148	175
lime sand	175	179
lime shale & lime	179	193
shale w/ white lime	193	220
lime w/ sh. shale	220	305
sh. shale	305	326
concrete sand	326	349

Information upon completion of well:

- (1) Diameter 3 7/8 inches.
- (2) Total Depth 349 feet.
- (3) Water Level 45 feet below top of ground.
- (4) Cased to 344, Size 4x2
- (5) Screen: Size 2", Length 5'
- (6) Were any formations sealed against pollution?
_____ yes, _____ no.

If YES depth of formation _____
Why _____
Drillers Remarks: _____

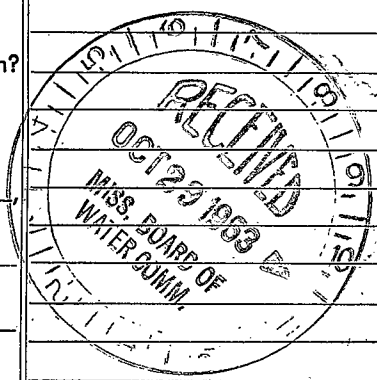

4

(Use Back Side)

Well No.

