

3
 NEWTON
 L 25
 2-1-64

P

WATER WELL DRILLERS LOG

Date: 2-1, 1964, Driller: V. L. Shelb County Newton
 (Name)

(1) Owner of Land: C. Chaney
 (Name)
Hickory Miss
 (Address)
 (2) Location: NW 1/4, NE 1/4, Sec. 18 T. 13 R. 13
4 miles N of Hickory
 (distance) (direction) (Nearest Town)
 (3) Topography: ✓
 (Hilly) (Flat) (Level)
 (4) Purpose of Well: Domestic
 (Domestic Irrigation
 Municipal, Industrial, Other)


Description & Color of Materials Sand, Clay, Red Clay, Shell, etc.	Thick-ness Feet	Depth Feet
<u>R clay</u>	<u>22</u>	<u>0-22</u>
<u>S clay</u>	<u>21</u>	<u>22-43</u>
<u>Blue</u>	<u>40</u>	<u>43-83</u>
<u>B. rocky</u>	<u>160</u>	<u>83-243</u>
<u>Sand</u>	<u>45</u>	<u>243</u>
		<u>1</u>
		<u>290</u>

Information upon completion of well:

(1) Diameter 3 1/2 inches.
 (2) Total Depth 290 feet.
 (3) Water Level 94 feet below top of ground.
 (4) Cased to 126, Size 2"
 (5) Screen: Size None, Length None
 (6) Were any formations sealed against pollution?
 _____ yes, _____ no.

If YES depth of formation _____
 Why _____

Drillers Remarks: _____

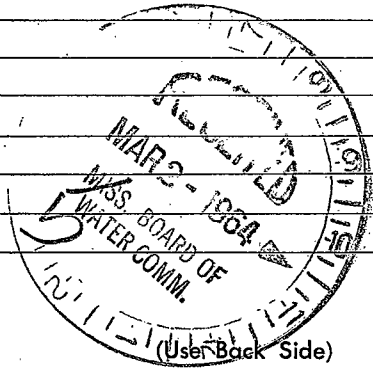

Well No. 89

372-2072
Bolan

362-2102