

L 26

2-10-64

WATER WELL DRILLERS LOG

Date: 2-10, 1964, Driller: Jerry, County: Land

(1) Owner of Land: W. E. Edwards (Name)

Heikow, Miss (Address)

(2) Location: 1/4, 1/4, Sec 29 T6R13

25 miles W, of MDN (distance, direction, Nearest Town)

(3) Topography: (Hilly) (Flat) (Level)

(4) Purpose of Well: Domestic (Domestic Irrigation, Municipal, Industrial, Other)


Table with 3 columns: Description & Color of Materials, Thickness Feet, Depth Feet. Entries include yellow sand, blue clay, shale & sand.

Information upon completion of well:

- (1) Diameter 4 inches. (2) Total Depth 350 feet. (3) Water Level 65' feet below top of ground. (4) Cased to 155', Size 4. (5) Screen: Size No, Length. (6) Were any formations sealed against pollution? no.

If YES depth of formation. Why

Drillers Remarks: pumps 75 gal per min

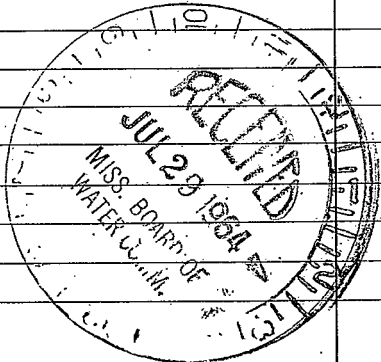

(Use Back Side)

Well No.

