

3
L27

P

WATER WELL DRILLERS LOG

2-19-64

Date: 2-19, 1964, Driller: W. L. Sheld County Newton
(Name)

(1) Owner of Land: H. Thorne
(Name)
Hickory Swiss
(Address)

(2) Location: SE 1/4, SE 5 1/4, Sec. 12, T6R12E
4 miles N, of Hickory
(distance) (direction) (Nearest Town)

(3) Topography: (Hilly) (Flat) (Level)

(4) Purpose of Well: Domestic
(Domestic Irrigation
Municipal, Industrial, Other)

Description & Color of Materials Sand, Clay, Red Clay, Shell, etc.	Thick- ness Feet	Depth Feet
<u>Med clay</u>	<u>22</u>	<u>0-22</u>
<u>S. clay</u>	<u>21</u>	<u>23-43</u>
<u>Blue</u>	<u>83</u>	<u>43-126</u>
<u>Blue Peasly</u>	<u>119</u>	<u>126-245</u>
<u>Sand</u>	<u>36</u>	<u>245-</u>
		<u>276</u>

Information upon completion of well:

(1) Diameter 3 1/2 inches.

(2) Total Depth 276 feet.

(3) Water Level 84 feet below top of ground.

(4) Cased to 112, Size 2"


(5) Screen: Size None, Length None.

(6) Were any formations sealed against pollution?
_____ yes, _____ no.

If YES depth of formation _____

Why _____

Drillers Remarks: _____

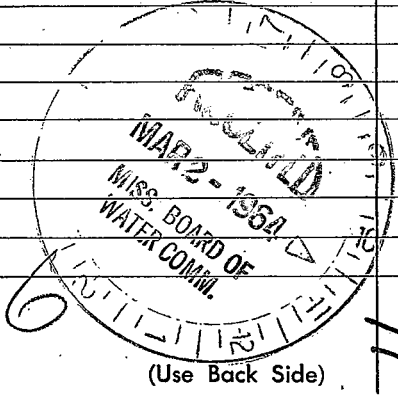

Well No.

(Use Back Side)

[The page contains extremely faint and illegible text, likely bleed-through from the reverse side of the document. No specific words or phrases can be discerned.]