

L 31
9-15-64

WATER WELL DRILLERS LOG

Date: 9-15, 1964, Driller: U. L. Welch County Newton
(Name)


- (1) Owner of Land: J. Walbon
(Name)
Hickory Miss
(Address)
- (2) Location: SE 1/4, NE 1/4, Sec. 27 T6 R12
1 miles NE of Hickory
(distance) (direction) (Nearest Town)
- (3) Topography: (Hilly) (Flat) (Level)
- (4) Purpose of Well: Domestic
(Domestic Irrigation
Municipal, Industrial, Other)

Description & Color of Materials Sand, Clay, Red Clay, Shell, etc.	Thick-ness Feet	Depth Feet
<u>Sandy clay</u>	<u>220-22</u>	
<u>blak</u>	<u>21 22-43</u>	
<u>Sand</u>	<u>29 43-100</u>	

Information upon completion of well:

- (1) Diameter 2" inches.
- (2) Total Depth 106 feet.
- (3) Water Level 12 feet below top of ground.
- (4) Cased to 106, Size 2"
- (5) Screen: Size 1/8 slot, Length 6'
- (6) Were any formations sealed against pollution?
_____ yes, no.

If YES depth of formation _____
Why _____
Drillers Remarks: _____

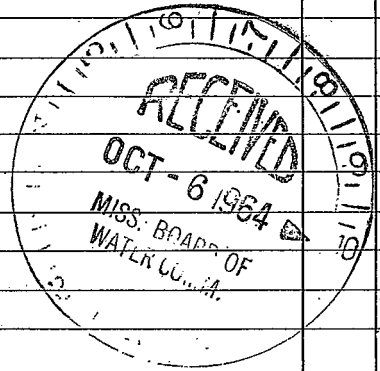

Well No. 109

(Use Back Side)

