

3
L 32

8

4-13-65 WATER WELL DRILLERS LOG

Date: 4-13, 1965, Driller: Bob Williamson County Newton
 (Name)

	Description & Color of Materials Sand, Clay, Red Clay, Shell, etc.	Thick- ness Feet	Depth Feet
(1) Owner of Land: <u>Rome Boase</u> <small>(Name)</small> <u>Hickory Rt. 1</u> <small>(Address)</small>	<u>white sand</u>	<u>152</u>	<u>1-152</u>
(2) Location: <u>SE 1/4, SW 1/4, Sec. 22 T. 6 R. 12</u> <u>2</u> miles <u>West</u> of <u>Hickory</u> <small>(distance)</small> <small>(direction)</small> <small>(Nearest Town)</small>			
(3) Topography: <u>hilly</u> <small>(Hilly)</small> <small>(Flat)</small> <small>(Level)</small>			
(4) Purpose of Well: <u>domestic</u> <small>(Domestic Irrigation Municipal, Industrial, Other)</small>			

Information upon completion of well:

(1) Diameter 2 inches.

(2) Total Depth 152 feet.

(3) Water Level 62 feet below top of ground.

(4) Cased to 147, Size 2"


(5) Screen: Size 2", Length 5ft.

(6) Were any formations sealed against pollution?
 yes, no.

If YES depth of formation _____

Why _____

Drillers Remarks: _____

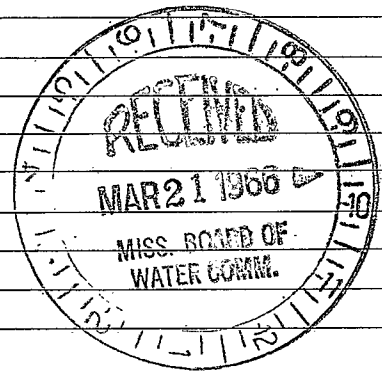

Well No.

(Use Back Side)

