

NEWTON
L33

WATER WELL DRILLERS LOG

P

Date: 3-16-66, 1966, Driller: M. E. Donald & H. W. Inc County Newton

(Name)

(1) Owner of Land: Gerald Holt
Decatur, Miss
(Address)

(2) Location: 1/4, 1/4, Sec. 1 T6R12
5 miles N of Hickory
(distance) (direction) (Nearest Town)

(3) Topography: X
(Hilly) (Flat) (Level)

(4) Purpose of Well: DOMESTIC
(Domestic Irrigation
Municipal, Industrial, Other)

Description & Color of Materials Sand, Clay, Red Clay, Shell, etc.	Thick- ness Feet	Depth Feet
CLAY	0	14
SAND	14	30
SHALE	30	90
SANDY	90	110
SHALE ST ROCK	110	250
SAND	250	280

Information upon completion of well:

(1) Diameter 8 3/8 inches. TEST HOLE

(2) Total Depth 280' feet.

(3) Water Level 80' feet below top of ground.

(4) Cased to 273, Size 2"


(5) Screen: Size 2", Length 5'

(6) Were any formations sealed against pollution?
no

If YES depth of formation _____

Why _____

Drillers Remarks: _____

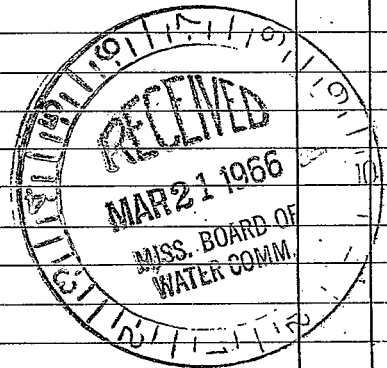

(Use Back Side)

Well No.

