

3

Newton
L35
4-67

MISSISSIPPI
 BOARD OF WATER COMMISSIONERS
 416 North State Street
 Jackson, Mississippi 39201

WATER WELL DRILLERS LOG

4-16 1967 U. L. Walsh Newton
 date well completed firm name county well located

LANDOWNER: Newton
Country Club
Newton, Miss.
 (mailing address)

WELL LOCATION:
 sec. 30 T 6 N R 12 E
 S W
3 mi miles East of Newton
 (distance) (direction) (nearest town)


WELL PURPOSE: irrigation
 (home, irrigation, municipal, industrial)

WELL COMPLETION DATA:

(1) diameter (inches) 4" - 2"
 (2) total depth (feet) 149
 (3) static water level (feet) 24 below above
 top of ground.
 (4) casing Steel
 (material) (depth)
 _____ if telescope see back.
 (size)
 (5) screen 18' _____
 (length) (depth to top)
2" _____
 (size) (material)
 (6) pump 3/4 1650
 (HP) (yield gpm)
Electric
 (type power)
 (7) electric log no
 (yes or no)

 (organization running log)
 (8) how well bottom plugged
Steel cap

description of formations encountered	from	to
<u>Yellow clay</u>	<u>0</u>	<u>22</u>
<u>Blue</u>	<u>32</u>	<u>110</u>
<u>Blue + Sandy</u>	<u>110</u>	<u>117</u>
<u>Sand</u>	<u>117</u>	<u>149</u>

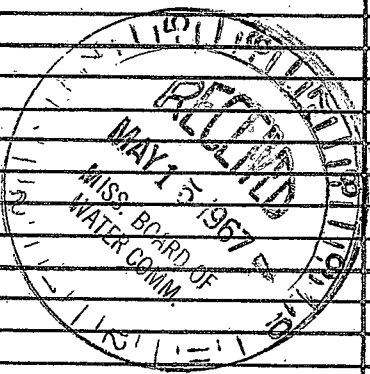

DRILLERS REMARKS:

