

Newton
 L 37 CODED
 6-68

MISSISSIPPI
 BOARD OF WATER COMMISSIONERS
 416 North State Street
 Jackson, Mississippi 39201

WATER WELL DRILLERS LOG

6-15 1968 U. P. Galch Newton
 date well completed firm name county well located

LANDOWNER:

B. Galch
 Hickory Miss
 (mailing address)

description of formations encountered

from to

R. clay	0	12
S. clay	17	22
Yellow clay	22	54
Red sand	54	65
W sand	65	90

WELL LOCATION:

sec 26 T 6 N R 12 E
 S W
 1 1/2 miles NW of Hickory
 (distance) (direction) (nearest town)

WELL PURPOSE:

(home, irrigation, municipal, industrial)

WELL COMPLETION DATA:

- (1) diameter (inches) 2"
- (2) total depth (feet) 90'
- (3) static water level (feet) 42' below above top of ground.
- (4) casing 40 steel 8K (material) (depth)

_____ if telescope see back.
 (size)

- (5) screen 6' (length) (depth to top)
- 2" Brass (size) (material)

- (6) pump 3 (HP) 400 (yield gpm)
- Electric (type power)

- (7) electric log _____ (yes or no)

_____ (organization running log)

- (8) how well bottom plugged _____


DRILLERS REMARKS:

CODED

JUN 18 1968
 MISS. BD. OF
 WATER COMMISSIONERS

If well telescopes please sketch and show depths.

GROUND LEVEL

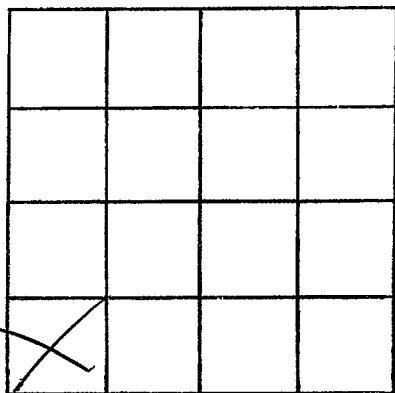

SECTION _____

Please indicate well location X.

ADDITIONAL INFORMATION

If more than one screen,
show locations of each on sketch.