

Newton
 L38
 6-25-68

MISSISSIPPI
 BOARD OF WATER COMMISSIONERS
 416 North State Street
 Jackson, Mississippi 39201

WATER WELL DRILLERS LOG

June 25 1968 Williamson Drilling Co. Newton
 date well completed firm name county well located


LANDOWNER: Robert A. Johnson
Hickory, Miss.
 (mailing address)

description of formations encountered	from	to
<u>Red Clay</u>	<u>0</u>	<u>5</u>
<u>Blue Clay</u>	<u>5</u>	<u>30</u>
<u>sand</u>	<u>30</u>	<u>125</u>
<u>Blue Clay</u>	<u>125</u>	<u>150</u>
<u>Shell</u>	<u>150</u>	<u>325</u>
<u>sand</u>	<u>325</u>	<u>375</u>

WELL LOCATION:
 sec. 23 T. 60 N. R. 12 E.
1 1/2 miles North Hickory
 (distance) (direction) (nearest town)

WELL PURPOSE: Home
 (home, irrigation, municipal, industrial)


- WELL COMPLETION DATA:
- (1) diameter (inches) 4
 - (2) total depth (feet) 375
 - (3) static water level (feet) 89 below above top of ground.
 - (4) casing Block. 131 ft.
 (material) (depth)
4 if telescope see back.
 (size)
 - (5) screen No
 (length) (depth to top)
 (size) (material)
 - (6) pump 1 23
 (HP) (yield gpm)
Elect.
 (type power)
 - (7) electric log No
 (yes or no)
No
 (organization running log)
 - (8) how well bottom plugged Open

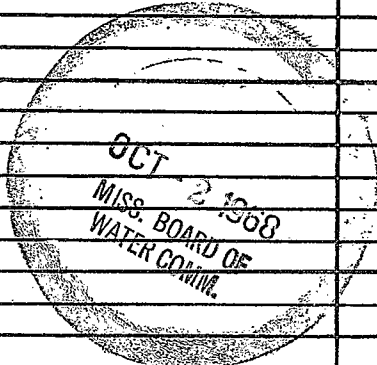

DRILLERS REMARKS:

If well telescopes please sketch and show depths.

GROUND LEVEL

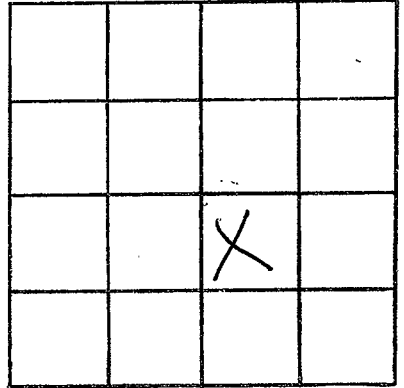

SECTION 23

Please indicate well location X.

ADDITIONAL INFORMATION

If more than one screen,
show locations of each on sketch.