

Newton
 L 39
 6-29-68

MISSISSIPPI
 BOARD OF WATER COMMISSIONERS
 416 North State Street
 Jackson, Mississippi 39201

WATER WELL DRILLERS LOG

June 29 1968 Williamson Drilling Newton
 date well completed firm name county well located

LANDOWNER: D. F. Ferguson

description of formations encountered

from to

Hickory, Miss.

Top soil
Blue Clay
sand

0 5
5 30
30 50

(mailing address)

WELL LOCATION:


sec 23 T. 6 N R. 12 E
 S W
 2 miles north of Hickory
 (distance) (direction) (nearest town)

WELL PURPOSE: Home
 (home, irrigation, municipal, industrial)

WELL COMPLETION DATA:

- (1) diameter (inches) 2
- (2) total depth (feet) 70
- (3) static water level (feet) 45 below top of ground.
- (4) casing 64 (material), 64 (depth)
 2 (size) if telescope see back.
- (5) screen 6 (length), 64 (depth to top)
 2 (size), stainless steel (material)
- (6) pump 1/2 (HP), 6 (yield gpm)
 Elect. (type power)
- (7) electric log no (yes or no)
 no (organization running log)
- (8) how well bottom plugged Cap


CODED

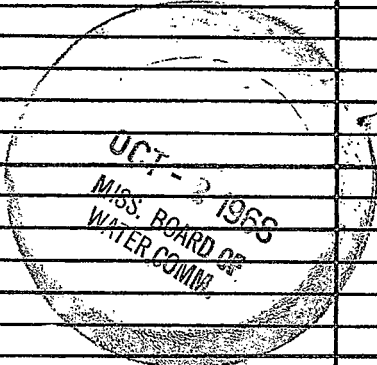

DRILLERS REMARKS:

If well telescopes please sketch and show depths.

GROUND LEVEL

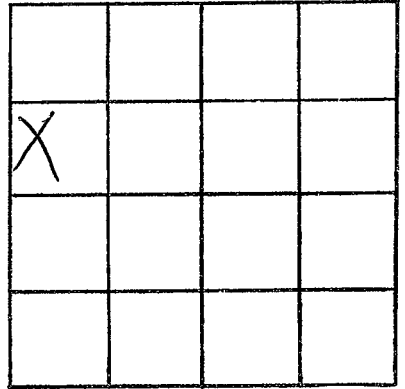

SECTION 23

Please indicate well location X.

ADDITIONAL INFORMATION

If more than one screen, show locations of each on sketch.