

Newton
L 40
7-19-68

MISSISSIPPI
 BOARD OF WATER COMMISSIONERS
 416 North State Street
 Jackson, Mississippi 39201

WATER WELL DRILLERS LOG

July 19 1968 Williamson Drilling Co. Newton
 date well completed firm name county well located


LANDOWNER: D.K. Walker
Hickory, Miss.
 (mailing address)

WELL LOCATION:
 sec. 35 T. 6 N. R. 12 E.
4 miles West of Hickory
 (distance) (direction) (nearest town)

WELL PURPOSE: Home
 (home, irrigation, municipal, industrial)

- WELL COMPLETION DATA:
- (1) diameter (inches) 4
 - (2) total depth (feet) 380
 - (3) static water level (feet) 83 below above top of ground.
 - (4) casing Blk 139
 (material) (depth)
 - 4 if telescope see back.
 (size)
 - (5) screen no
 (length) (depth to top)
 - (size) (material)
 - (6) pump 1/2 9
 (HP) (yield gpm)
 - Elect.
 (type power)
 - (7) electric log no
 (yes or no)
 - no
 (organization running log)
 - (8) how well bottom plugged open


description of formations encountered	CODED	from	to
<u>Red Clay</u>		<u>0</u>	<u>7</u>
<u>Red sand</u>		<u>7</u>	<u>12</u>
<u>White sand</u>		<u>12</u>	<u>50</u>
<u>Blue Clay</u>		<u>50</u>	<u>65</u>
<u>sand</u>		<u>65</u>	<u>125</u>
<u>Blue Clay</u>		<u>125</u>	<u>145</u>
<u>shell</u>		<u>145</u>	<u>330</u>
<u>sand</u>		<u>330</u>	<u>380</u>

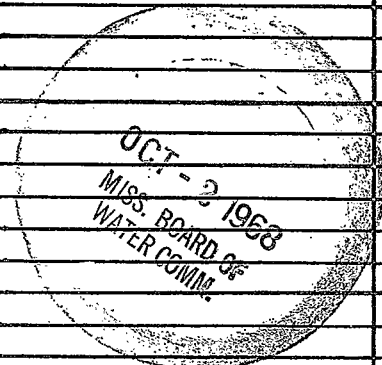

DRILLERS REMARKS:

If well telescopes please sketch and show depths.

GROUND LEVEL

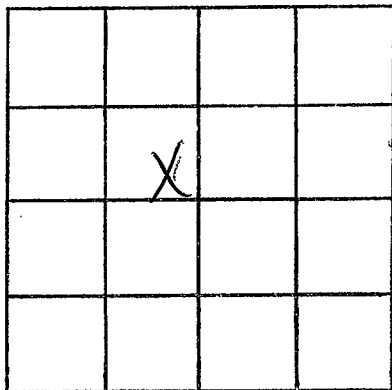

SECTION 35

Please indicate well location X.

ADDITIONAL INFORMATION

If more than one screen, show locations of each on sketch.