

Newton
L 41
6-29-68

MISSISSIPPI  
BOARD OF WATER COMMISSIONERS  
416 North State Street  
Jackson, Mississippi 39201

WATER WELL DRILLERS LOG

June 29 1968 Williamson Drilling Newton  
 date well completed firm name county well located

LANDOWNER: J. T. Harris  
Hickory, Miss.  
 (mailing address)

description of formations encountered	from	to
<u>top soil</u>	<u>0</u>	<u>3</u>
<u>red sand</u>	<u>3</u>	<u>15</u>
<u>white sand</u>	<u>15</u>	<u>130</u>
<u>blue clay</u>	<u>130</u>	<u>160</u>
<u>shell &amp; pebbles</u>	<u>160</u>	<u>335</u>
<u>sand</u>	<u>335</u>	<u>380</u>

WELL LOCATION:  
 sec. 26 T. 6 N. R. 12 E  
1 miles North of Hickory  
 (distance) (direction) (nearest town)

WELL PURPOSE: Home  
 (home, irrigation, municipal, industrial)

WELL COMPLETION DATA:

(1) diameter (inches) 4

(2) total depth (feet) 380

(3) static water level (feet) 77 <sup>below</sup> <sub>above</sub> top of ground.

(4) casing Black F. 136  
 (material) (depth)

4 (size) If telescope see back.

(5) screen 0 (length) (depth to top)

(size) (material)

(6) pump 1 23  
 (HP) (yield gpm)

Elect.  
 (type power)


(7) electric log No  
 (yes or no)

No  
 (organization running log)

(8) how well bottom plugged Open

CODED


CODED

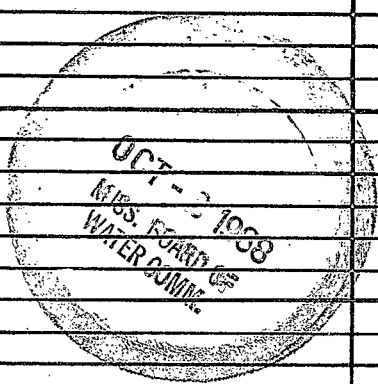

DRILLERS REMARKS:

If well telescopes please sketch and show depths.

GROUND LEVEL

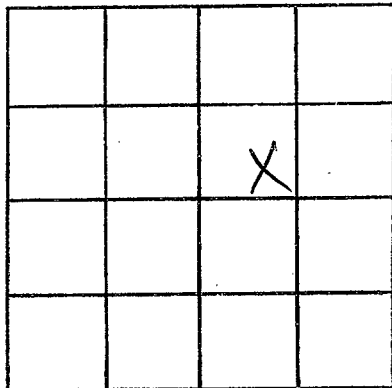

SECTION ~~26~~ 26

Please indicate well location X.

ADDITIONAL INFORMATION

If more than one screen,  
show locations of each on sketch.