

Newton
L 42
2-24-69

MISSISSIPPI
BOARD OF WATER COMMISSIONERS
416 North State Street
Jackson, Mississippi 39201

CODED

WATER WELL DRILLERS LOG

2.24.69 date well completed
McDONALD + HILL firm name
NEWTON county well located

LANDOWNER: GERALD HARRIS

Hickory Miss

(mailing address)

WELL LOCATION:

sec. 25 T 6 N R. 12 E
S W
1 miles NORTH of Hickory
(distance) (direction) (nearest town)

WELL PURPOSE: HOME
(home, irrigation, municipal, industrial)

WELL COMPLETION DATA:

- (1) diameter (inches) 4"
- (2) total depth (feet) 200'
- (3) static water level (feet) 68' below top of ground.
- (4) casing BLACK, 126'
(material) (depth)
4" if telescope see back.
(size)
- (5) screen _____
(length) (depth to top)
(size) (material)
- (6) pump 2 10
(HP) (yield gpm)
220
(type power)
- (7) electric log NO
(yes or no)
(organization running log)
- (8) how well bottom plugged OPEN

description of fomations encountered

from to

CLAY	0	15
SAND	15	20
SHALE	20	38
SAND	38	110
SHALE	110	160
ROCK ST SHALE	160	185
SAND	185	200

CODED

FEB 27 1969


DRILLERS REMARKS:

MISS. BD. OF
WATER COM.

ABC

If well telescopes please sketch and show depths.

GROUND LEVEL

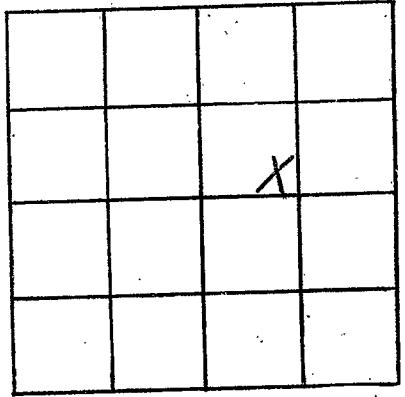

SECTION 25

Please indicate well location X.

ADDITIONAL INFORMATION

If more than one screen, show locations of each on sketch.