

CODED

MISSISSIPPI  
BOARD OF WATER COMMISSIONERS  
416 North State Street  
Jackson, Mississippi 39201

WATER WELL DRILLERS LOG

Newton  
L43  
9-69

Sept. 1969 Wilkeron Drilling Newton  
date well completed firm name county well located

LANDOWNER:

Mr L.A. Davis  
Newton MISS  
(mailing address)

description of formations encountered

from to

yellow clay 0 40  
clay & sand 40 95  
sand 95 135

WELL LOCATION:

sec. 2 T 6 N R 12 E  
S W  
7 miles E of Newton  
(distance) (direction) (nearest town)

WELL PURPOSE:

home  
(home, irrigation, municipal, industrial)

WELL COMPLETION DATA:

- (1) diameter (inches) 2
- (2) total depth (feet) 130
- (3) static water level (feet) 20 below above top of ground.
- (4) casing Galv., 126,  
(material) (depth)  
2 if telescope see back.  
(size)
- (5) screen 4, 130  
(length) (depth to top)  
2, Stainless  
(size) (material)
- (6) pump 1, 10  
(HP) (yield gpm)  
Spec  
(type power)
- (7) electric log NO  
(yes or no)

(organization running log)

(8) how well bottom plugged 2 BWD


DRILLERS REMARKS:

OCT 27 1969

MUSE BY ALL  
WATER BUREAU

If well telescopes please sketch and show depths.

GROUND LEVEL

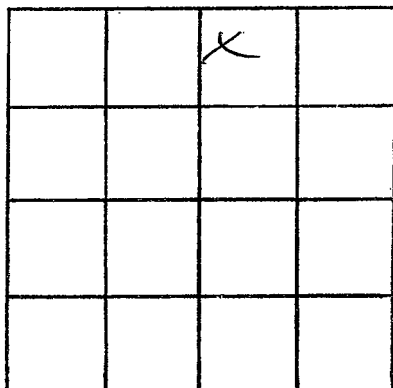

SECTION 2

Please indicate well location X.

ADDITIONAL INFORMATION

If more than one screen,  
show locations of each on sketch.