

Newton
L 15 L 44
6-11-69

MISSISSIPPI
 BOARD OF WATER COMMISSIONERS
 416 North State Street
 Jackson, Mississippi 39201

CODEN

WATER WELL DRILLERS LOG

6-11- 1969 Williamson Drilling Newton
 date well completed firm name county well located

LANDOWNER: John Youngland
Richard Smith
 (mailing address)

description of formations encountered	depth	
	from	to
<u>top soil</u>	<u>0</u>	<u>3</u>
<u>red clay</u>	<u>3</u>	<u>8</u>
<u>Blue Clay</u>	<u>8</u>	<u>40</u>
<u>white sand</u>	<u>40</u>	<u>135</u>
<u>Brown Clay</u>	<u>135</u>	<u>170</u>
<u>Green Rock & Clay</u>	<u>170</u>	<u>320</u>
<u>sand</u>	<u>320</u>	<u>360</u>

WELL LOCATION:
 sec 25 T 6N R 12E
1 miles N of Galaxy
 (distance) (direction) (nearest town)

WELL PURPOSE: Home
 (home, irrigation, municipal, industrial)


- WELL COMPLETION DATA:
- (1) diameter (inches) 4
 - (2) total depth (feet) 360
 - (3) static water level (feet) 51 below above top of ground.
 - (4) casing Black 142
 (material) (depth)
 - 4 if telescope see back.
 (size)
 - (5) screen no (depth to top)
 (size) (material)
 - (6) pump 3/4 12
 (HP) (yield gpm)
Elect
 (type power)
 - (7) electric log no (yes or no)
no
 (organization running log)
 - (8) how well bottom plugged open

DRILLERS REMARKS:

NOV 15 1969
 MISSISSIPPI BOARD OF WATER COMMISSIONERS

If well telescopes please sketch and show depths.

GROUND LEVEL

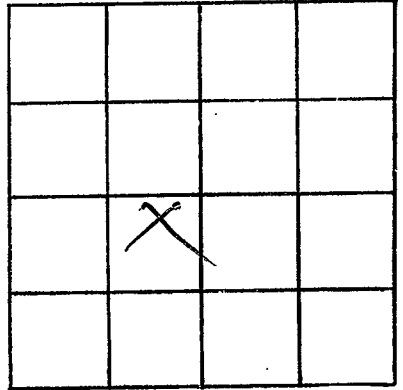

SECTION 25

Please indicate well location X.

ADDITIONAL INFORMATION

If more than one screen, show locations of each on sketch.