

Newton Co



L 46

3-18-70

MISSISSIPPI BOARD OF WATER COMMISSIONERS
416 North State Street
Jackson, Mississippi 39201



Newton Co

WATER WELL DRILLERS LOG

3-18-70
date well completed

1970 Williamson Drilling & Construction
firm name

Newton Co
county well located

LANDOWNER: Ralph Chaney

Hickory, Miss
(mailing address)

description of formations encountered

from to

top soil	0	3
blue clay	3	15
sand	15	70
blue clay	70	90
sand	90	104
blue clay	104	150
green sand & clay	150	310
sand	310	350


WELL LOCATION:

sec. 25 T. 6 N. R. 12 E.
1 miles North of Hickory
(distance) (direction) (nearest town)

WELL PURPOSE: Home
(home, irrigation, municipal, industrial)

WELL COMPLETION DATA:

- (1) diameter (inches) 4
- (2) total depth (feet) 350
- (3) static water level (feet) 140 ^{below} _{above} top of ground.
- (4) casing Block (material) 108 (depth)
4 (size) if telescope see back.
- (5) screen no (length) (depth to top)
(size) (material)
- (6) pump 1/2 (HP) 10 (yield gpm)
Electric (type power)
- (7) electric log no (yes or no)
no (organization running log)
- (8) how well bottom plugged open

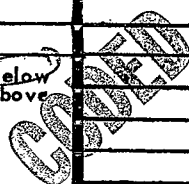


DRILLERS REMARKS:

MAR 25 1970

MISS. BD. OF WATER COMM.

If well telescopes please sketch and show depths.

GROUND LEVEL

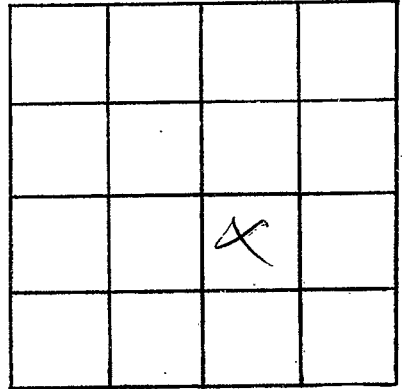

SECTION 25

Please indicate well location X.

ADDITIONAL INFORMATION

If more than one screen,
show locations of each on sketch.