

Newton
L 47
5-28-70
5

MISSISSIPPI
 BOARD OF WATER COMMISSIONERS
 416 North State Street
 Jackson, Mississippi 39201

WATER WELL DRILLERS LOG *ETN 6/11/70*
6-8-70

5.28.70 date well completed *McDONALD + HILL* firm name *NEWTON* county well located

LANDOWNER:
D. B. Herington ?
 DECATOR MISS
 (mailing address)
 WELL LOCATION: *008*
 sec. *30* T-*6* S R-*12* E
1 miles *SOUTH* of *DECATOR*
 (distance) (direction) (nearest town)

description of formations encountered	from	to
<i>Clay</i>	<i>0</i>	<i>4</i>
<i>Sandy St Clay</i>	<i>4</i>	<i>20</i>
<i>Sand</i>	<i>20</i>	<i>70</i>
<i>Shale</i>	<i>70</i>	<i>105</i>
<i>Rock St Shale</i>	<i>105</i>	<i>120</i>
<i>Rock St Green Sand</i>	<i>120</i>	<i>160</i>

WELL PURPOSE:
 (home, irrigation, municipal, industrial)


- WELL COMPLETION DATA:
- (1) diameter (inches) *4"*
 - (2) total depth (feet) *160*
 - (3) static water level (feet) *52* below/above top of ground.
 - (4) casing *Black*, *100'*
 (material) (depth)
4"
 (size) if telescope see back.
 - (5) screen *6*
 (length) (depth to top)
6 (size) (material)
 - (6) pump *1/2* *10*
 (HP) (yield gpm)
220
 (type power)
 - (7) electric log *NO*
 (yes or no)
NO
 (organization running log)
 - (8) how well bottom plugged *OPEN*

JUN 7 1970
 Miss. Bd. of WATER COMM

DRILLERS REMARKS:

If well telescopes please sketch and show depths.

GROUND LEVEL

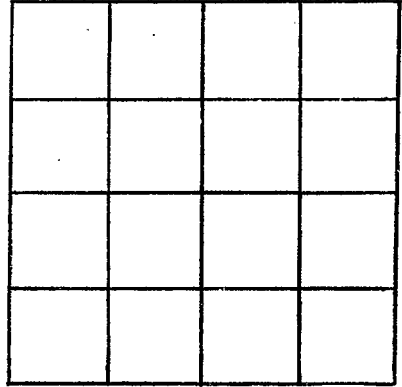

SECTION _____

Please indicate well location X.

ADDITIONAL INFORMATION

If more than one screen, show locations of each on sketch.